

87.8m

REFERENCE NUMBER:  
FUL/2017/1543

SITE:  
11-12 KING WILLIAM STREET

**NORTH**

(Club)

Saffron  
Court

12  
10  
6

7 8

11 12

Club

86.6m

1:1250

Bin storage to be enclosed by timber fencing (screened from view)

Proposed 8 Yard Skip  
Positioned across car parking bays 1 and 2 after event only. Bays will be clear for parking at all event

Existing trees

Gate

Rear Extension

Existing Building

Saffron Court

Club

20 No. Proposed Car Parking Spaces

87.8m

ALBERT STREET

86.6m

KING WILLIAM STREET


TCB

Block Plan  
Scale 1:200 @ A1

3m


GENERAL NOTES

DRAWING CAN BE SCALED FOR PLANNING PURPOSES ONLY BUT IF IN ANY DOUBT ABOUT A DIMENSION OR ANY OF THE DRAWN INFORMATION PLEASE ASK CDRB ARCHITECTS.

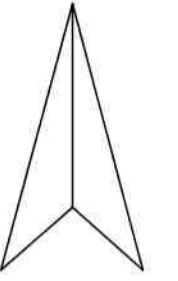




North

AS BUILT RETROSPECTIVE PLANNING SUBMISSION

revn	date	by	chkd
 <b>cdrb architects ltd</b> <small>8 Berkeley House, The Square, Kenilworth CV8 1EB</small>			
job title			
Extension and Change of Use to Banqueting Suite/Conference Centre, Boundary Wall and Railings and Change of Use of Public Amenity Space to Car Parking at 11 to 12 King William Street, Coventry, CV1 5JD			
drawing title			
Boundary Wall Enclosing Site - Change of Use from Public Amenity Space to Car Parking			
scale	drawn by	date	checked by
1:200 & 1:50 @A1	RH	October 2018	CDRB
job no.	drawing no.	revision	
T1016	AL (P) 10	-	

# 11 to 12 KING WILLIAM STREET, COVENTRY


**GENERAL NOTES**  
 DRAWING CAN BE SCALED FOR PLANNING PURPOSES ONLY BUT IF IN ANY DOUBT ABOUT A DIMENSION OR ANY OF THE DRAWN INFORMATION PLEASE ASK CDRB ARCHITECTS.

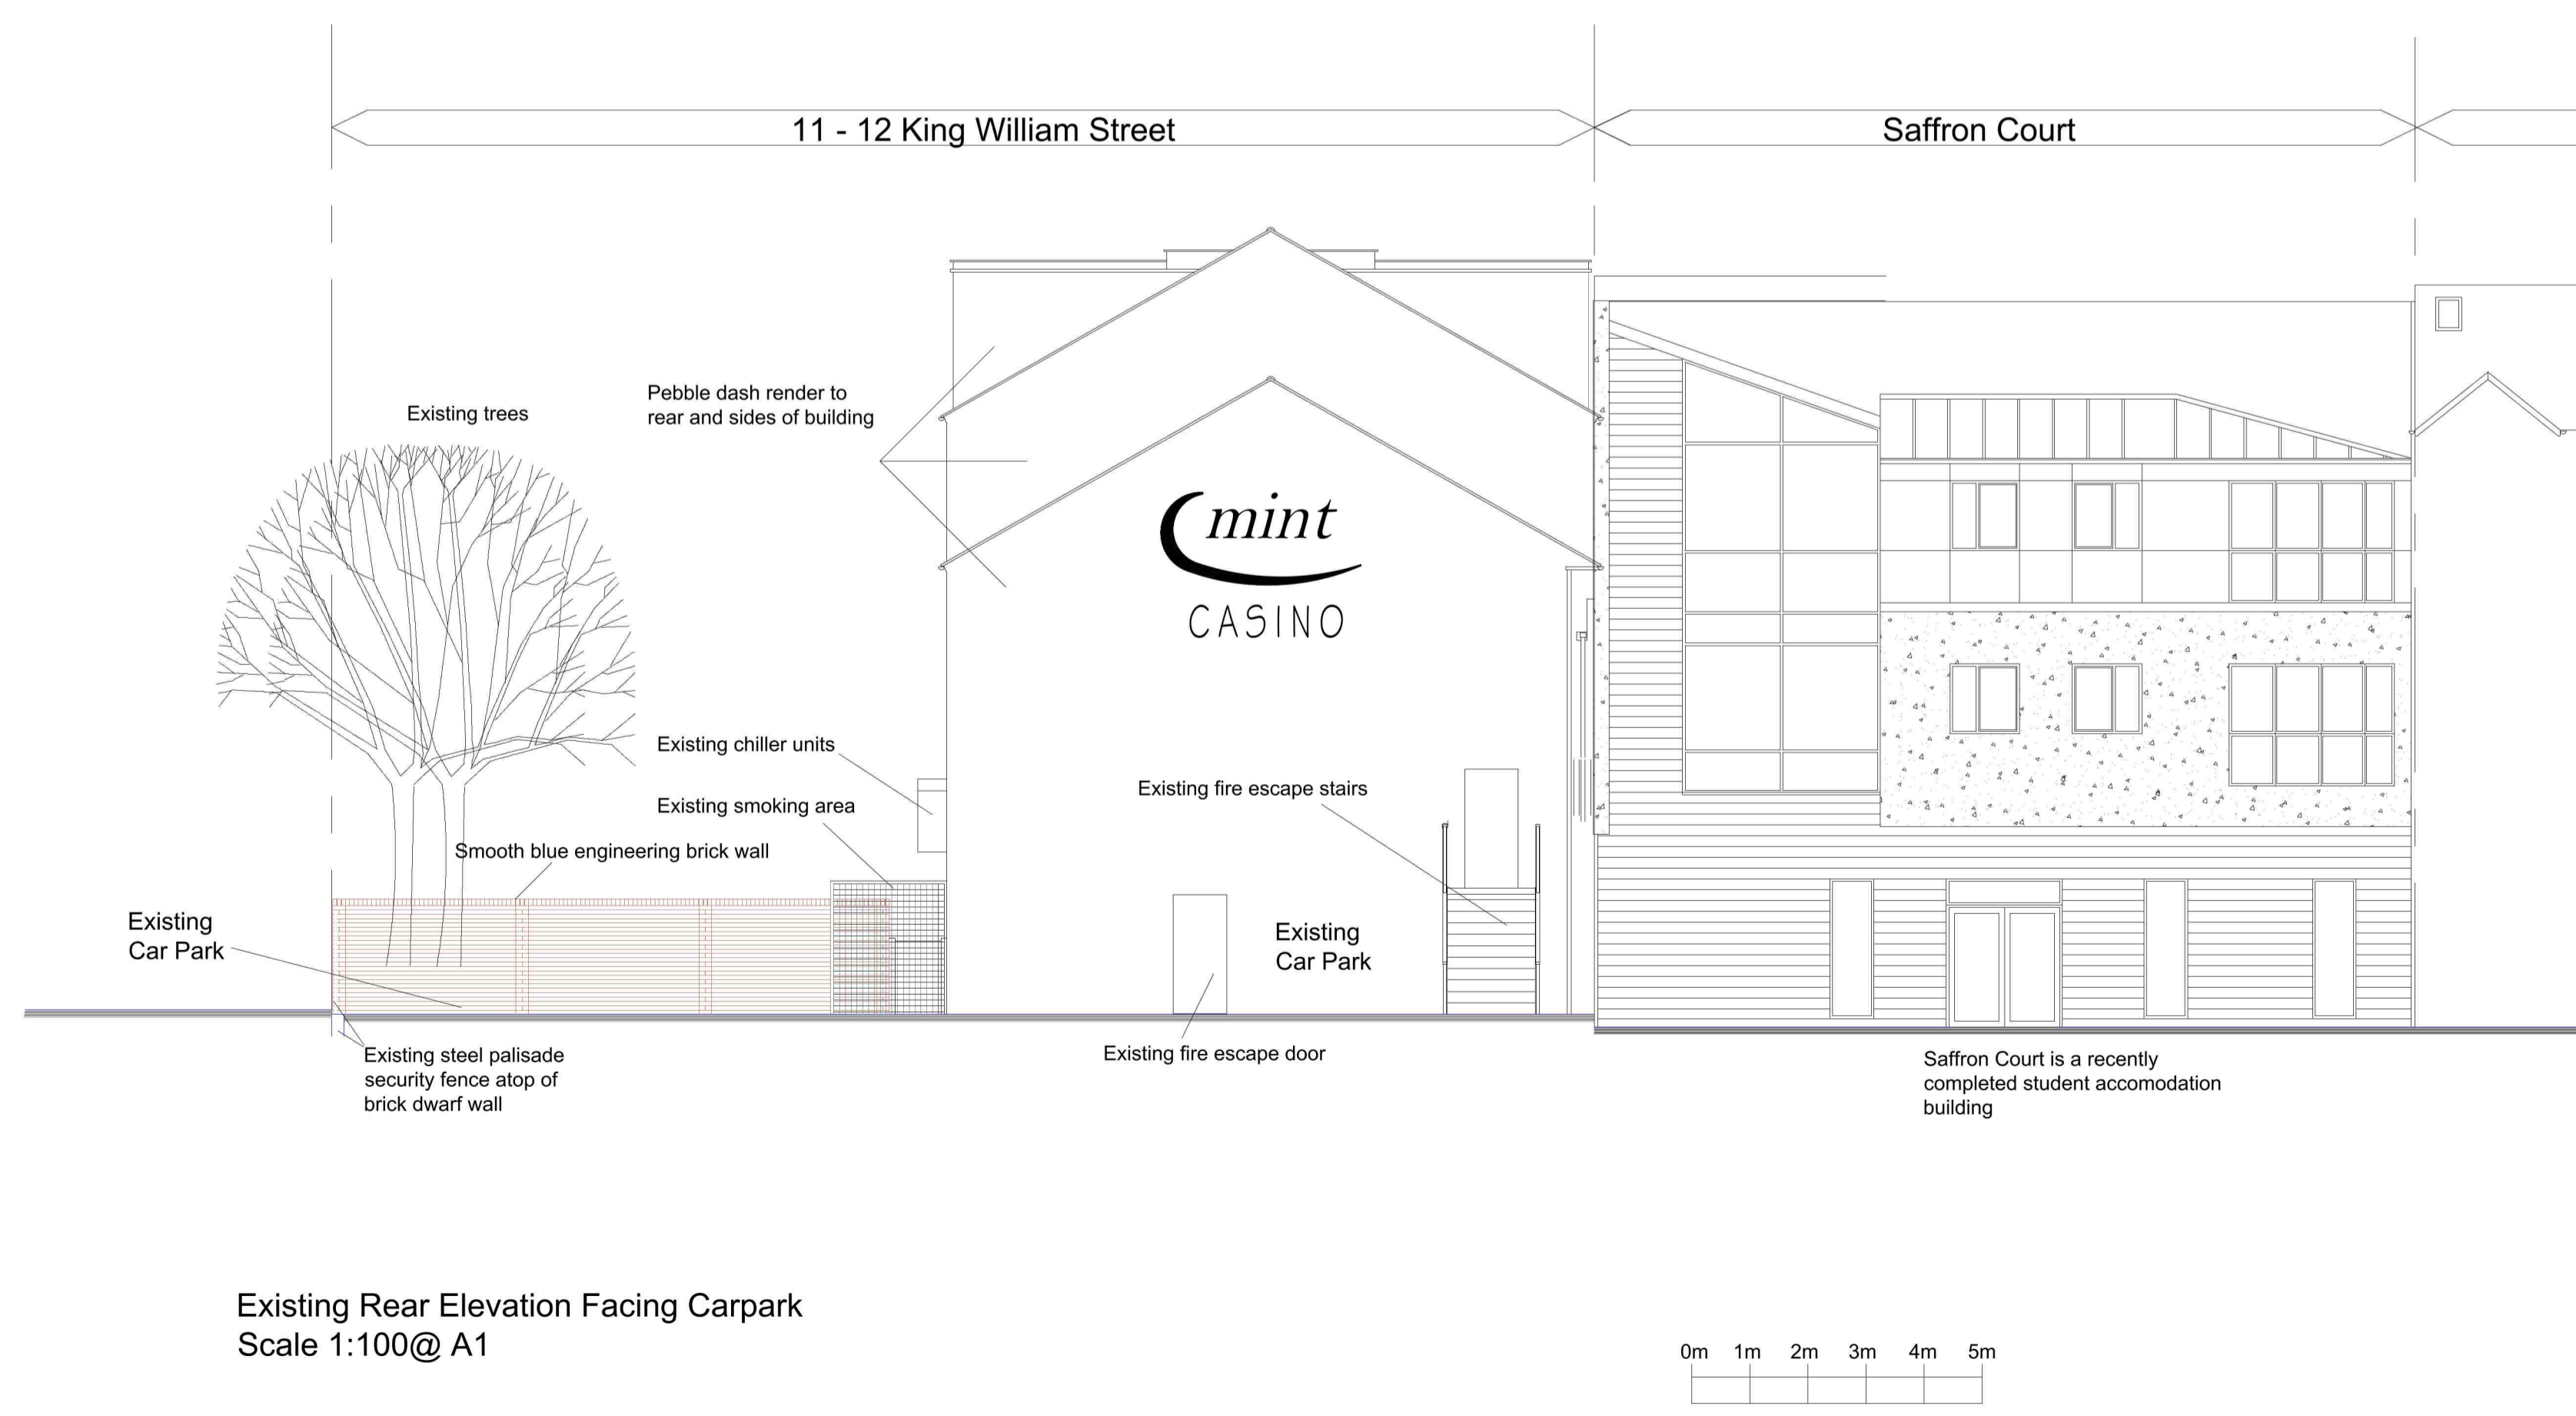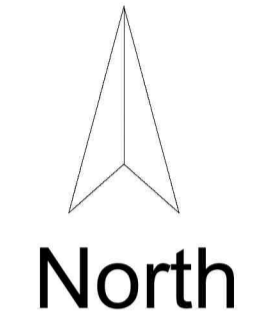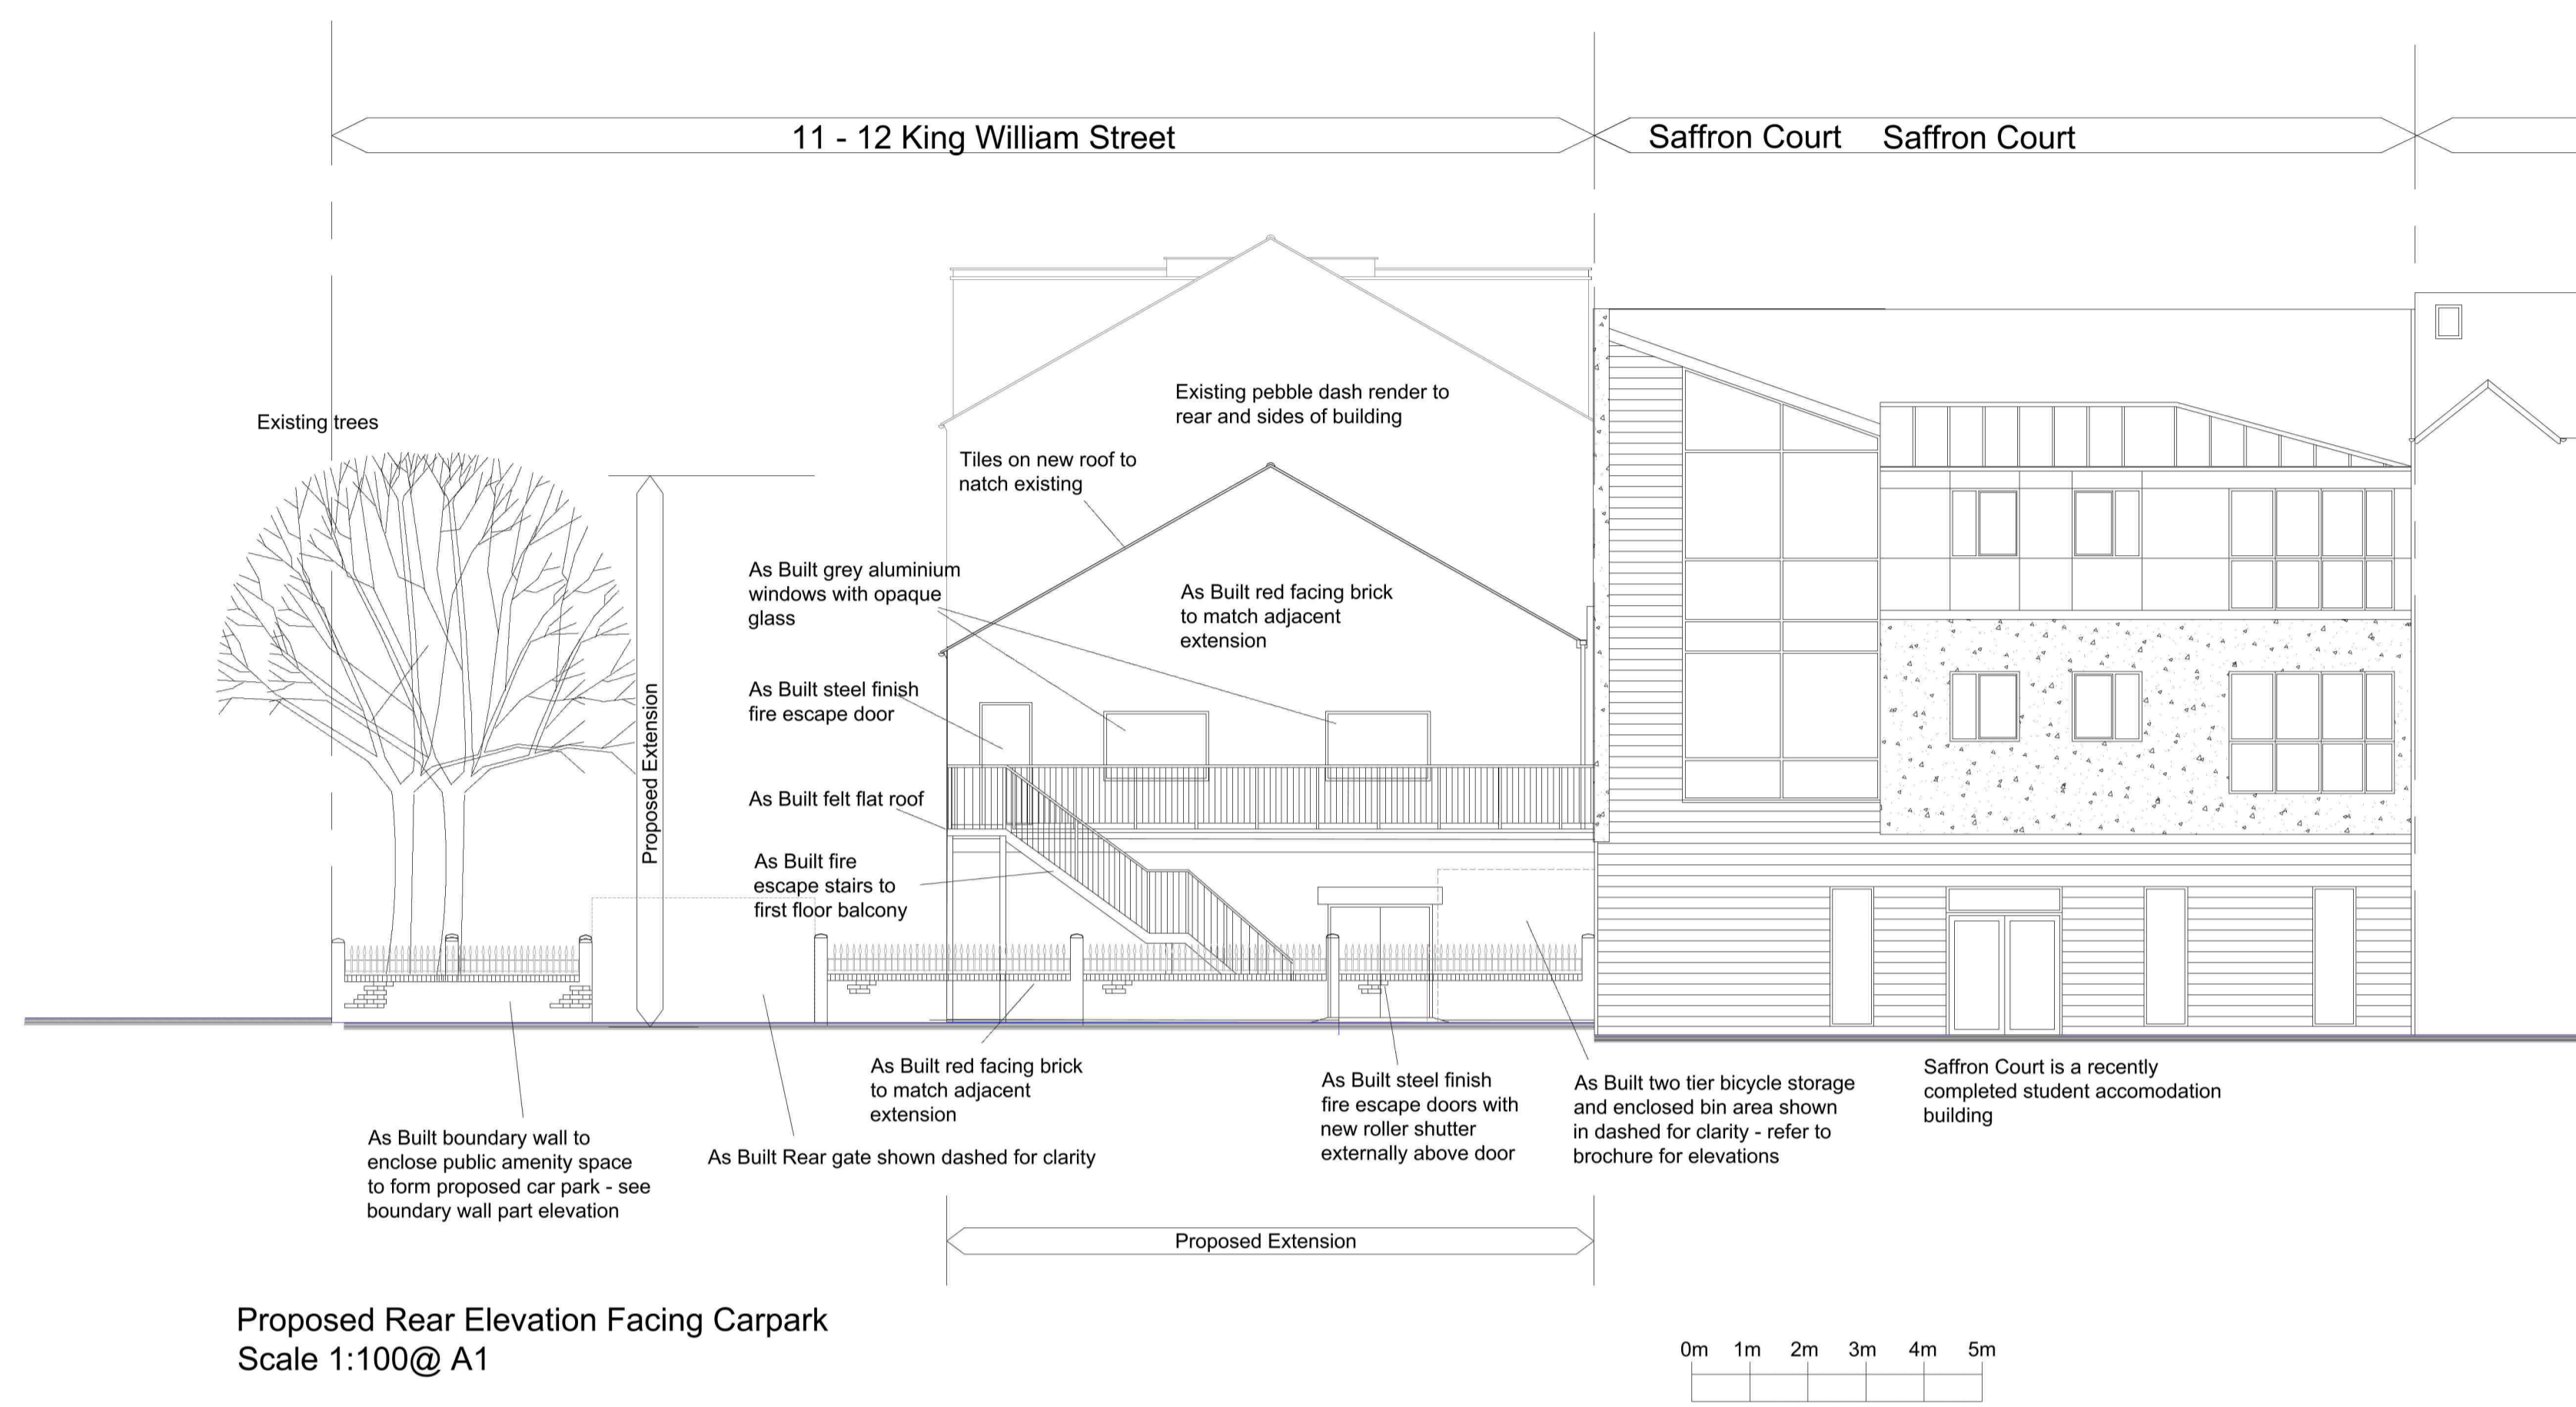


## AS BUILT RETROSPECTIVE PLANNING SUBMISSION

revn	date	by	chckd
cdrb architects ltd 8 The Square Kenilworth CV8 1EB			
job title Extension and Change of Use to Banqueting Suite/Conference Centre, Boundary Wall and Railings and Change of Use of Public Amenity Space to Car Parking at 11 to 12 King William Street, Coventry, CV1 5JD			
drawing title Proposed and Existing Rear Elevations facing car park and as seen in context			
scale	drawn by	date	checked by
1:100 @A1	TP	June 2017	CR
job no.	drawing no.	revision	
T1016	AL (P) 08	-	


**GENERAL NOTES**  
 DRAWING CAN BE SCALED FOR PLANNING PURPOSES ONLY BUT IF IN ANY DOUBT ABOUT A DIMENSION OR ANY OF THE DRAWN INFORMATION PLEASE ASK CDRB ARCHITECTS.

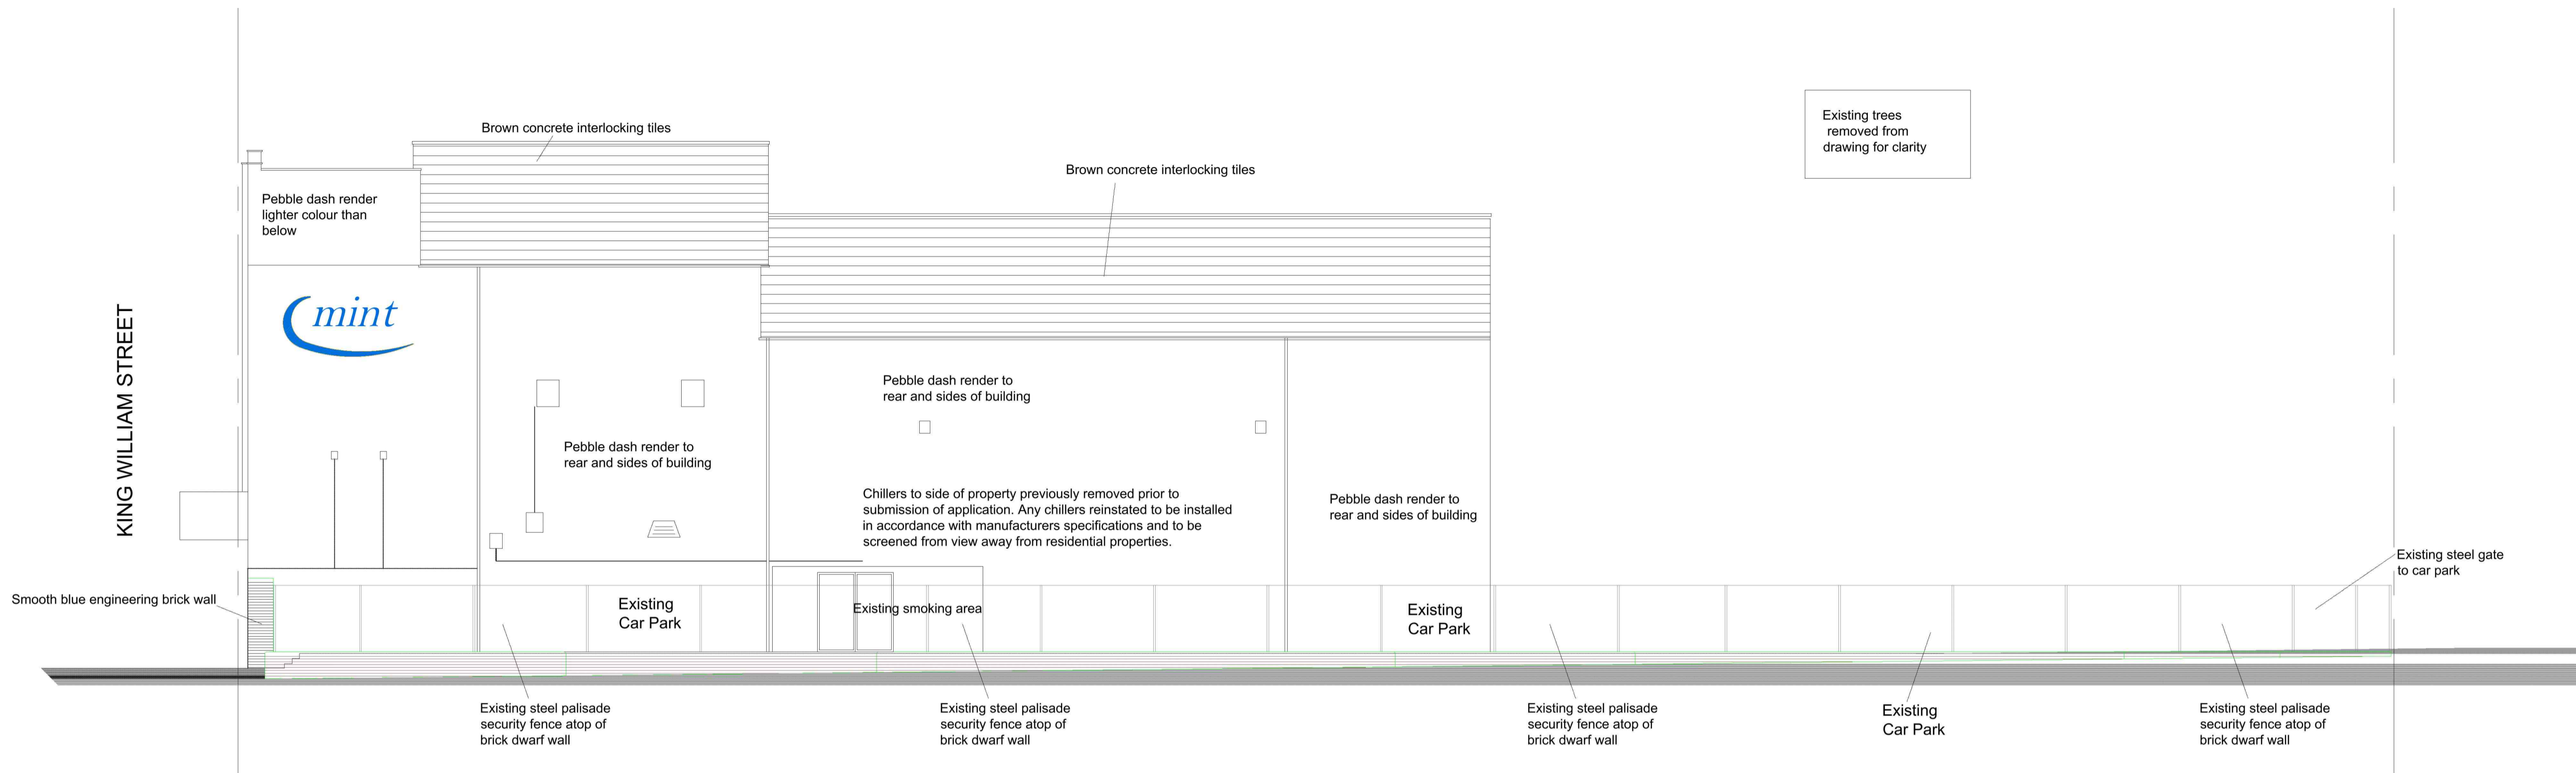

Existing Side Elevation - facing Clifton Street  
 (Elevation B on Key Diagram - seen in context of street)  
 Scale 1:100 @ A1

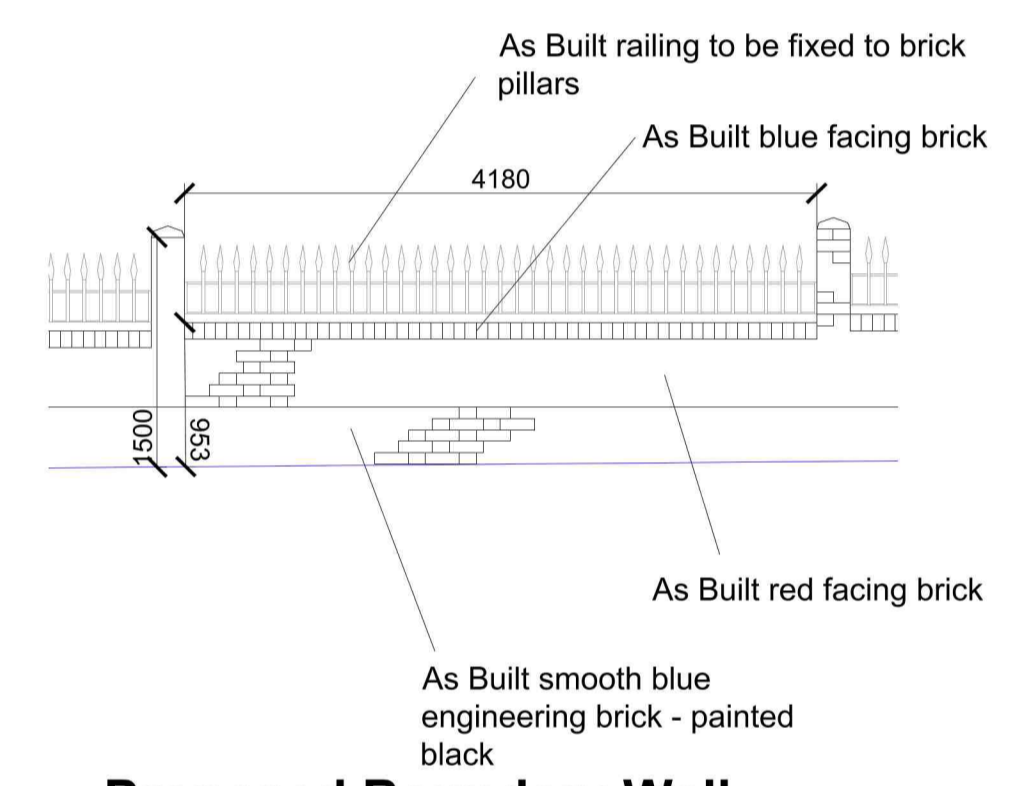

Proposed Boundary Wall  
 Part Elevation  
 Scale 1:50 @ A1

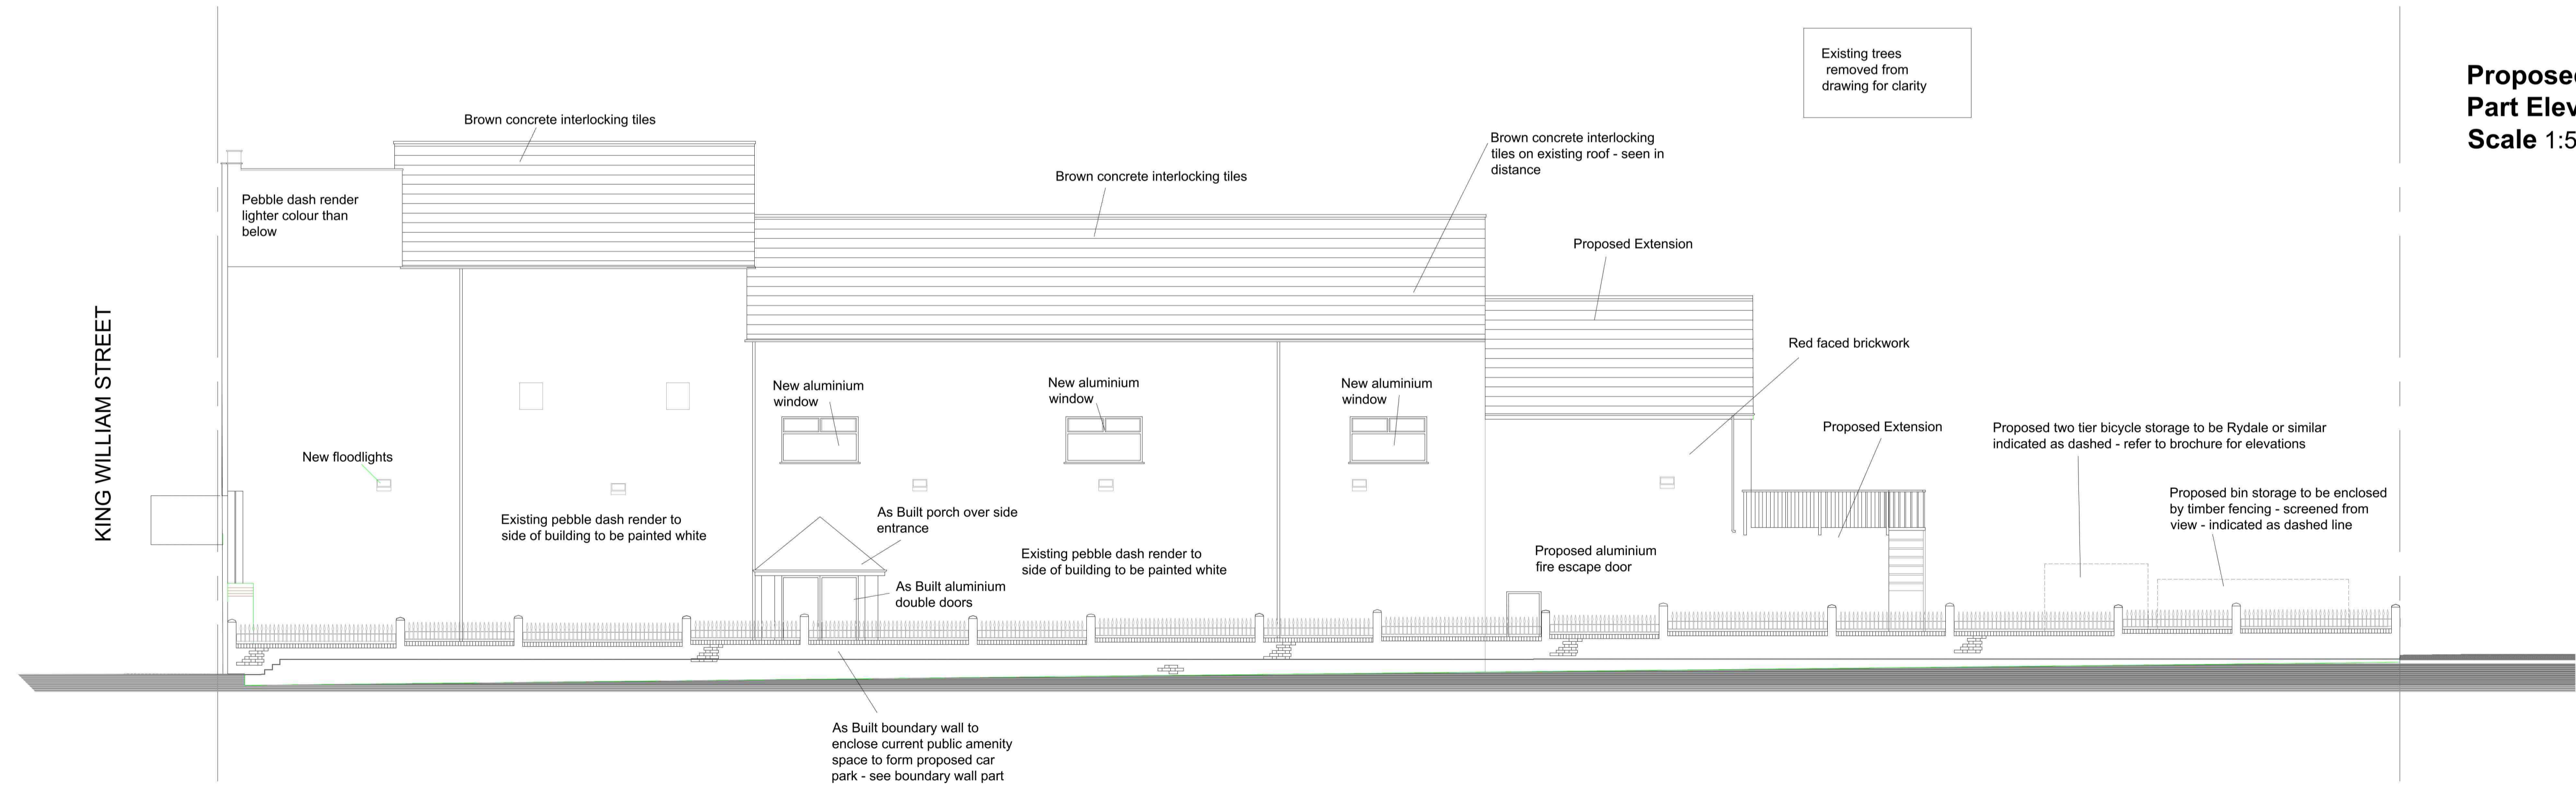

Proposed Side Elevation - facing Clifton Street  
 (Elevation B on Key Diagram - seen in context of street)  
 Scale 1:100 @ A1

**AS BUILT RETROSPECTIVE PLANNING SUBMISSION**


revn	date	by	chckd
cdrb architects ltd 8 The Square Kenilworth CV8 1EB			
job title Extension and Change of Use to Banqueting Suite/Conference Centre, Boundary Wall and Railings and Change of Use of Public Amenity Space to Car Parking at 11 to 12 King William Street, Coventry, CV1 5JD			
drawing title Proposed and Existing Side Elevations			
scale	drawn by	date	checked by
1:50 & 1:100 @A1	TP	June 2017	CDR
job no.	drawing no.	revision	
T1016	AL (P) 07	-	

# 11 to 12 KING WILLIAM STREET, COVENTRY

**GENERAL NOTES**  
 DRAWING CAN BE SCALED FOR PLANNING PURPOSES ONLY BUT IF IN ANY DOUBT ABOUT A DIMENSION OR ANY OF THE DRAWN INFORMATION PLEASE ASK CDRB ARCHITECTS.



Proposed Front Elevation Facing King William Street  
 (Elevation C on Key Diagram - seen in context of street)  
 Scale 1:100@ A1

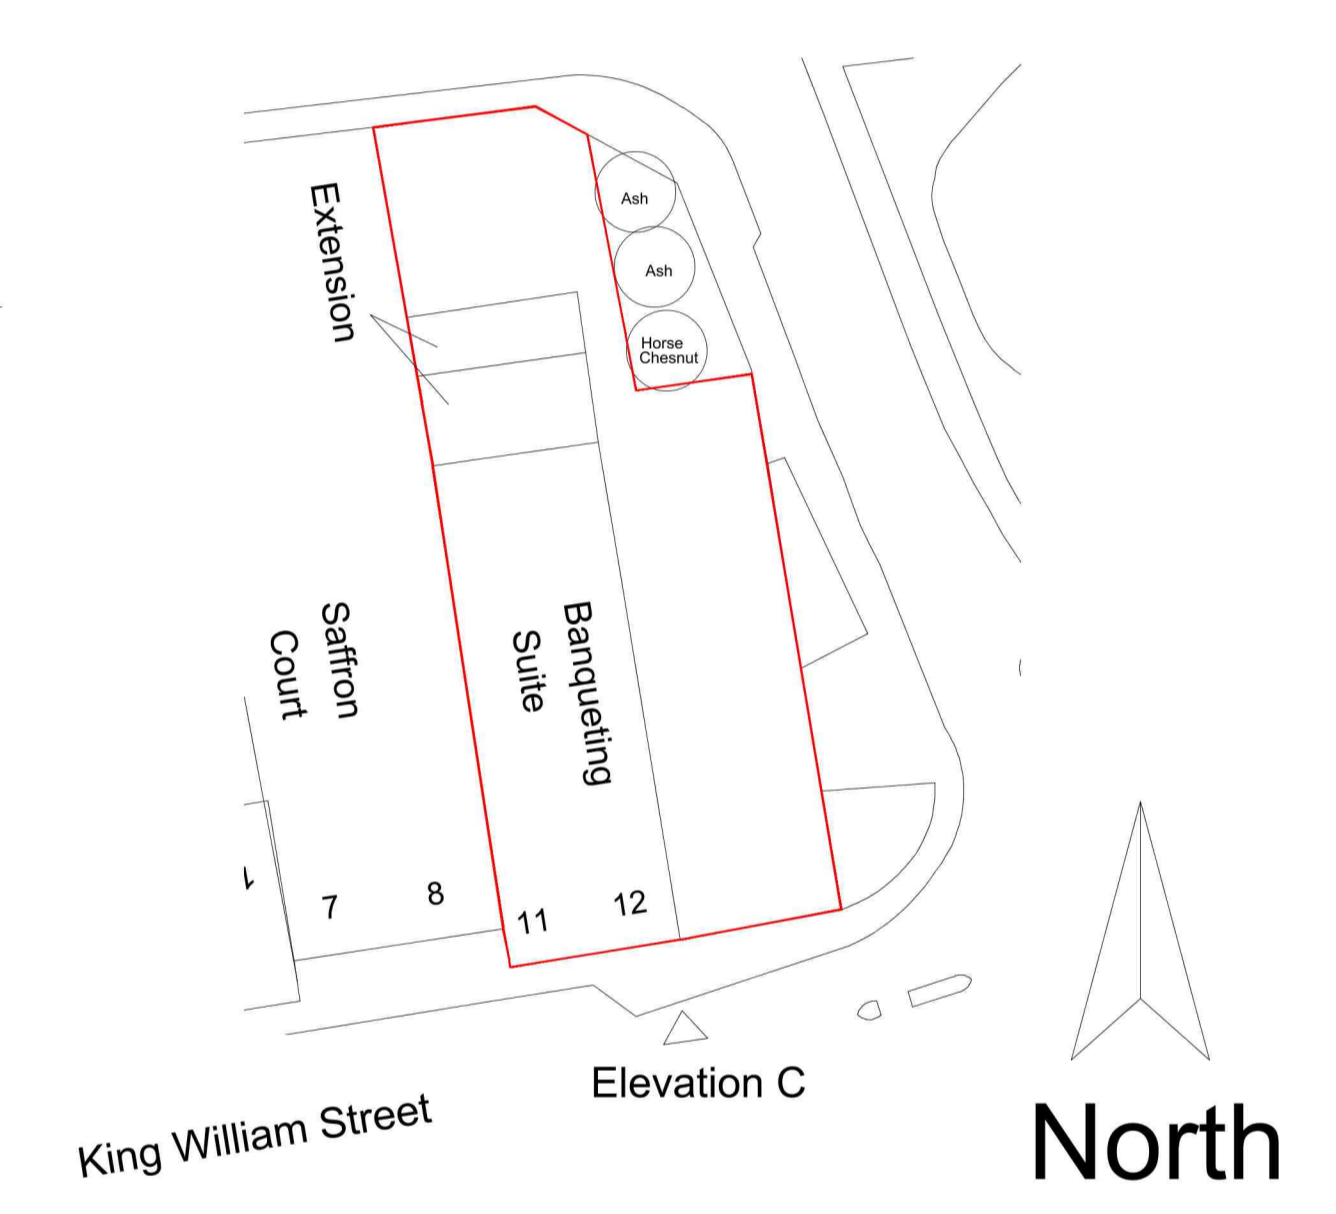

Key Diagram to Elevations  
 NTS





Existing Front Elevation Facing King William Street  
 (Elevation C on Key Diagram - seen in context of street)  
 Scale 1:100@ A1

## AS BUILT RETROSPECTIVE PLANNING SUBMISSION

revn	date	by	chckd
cdrb architects ltd 8 The Square Kenilworth CV8 1EB			
job title Extension and Change of Use to Banqueting Suite/Conference Centre, Boundary Wall and Railings and Change of Use of Public Amenity Space to Car Parking at 11 to 12 King William Street, Coventry, CV1 5JD			
drawing title Proposed and Existing Front Elevations facing King William Street and as seen in context			
scale	drawn by	date	checked by
1:100 @A1	TP	June 2017	CR
job no.	drawing no.	revision	
T1016	AL (P) 06	-	

# 11 to 12 KING WILLIAM STREET, COVENTRY

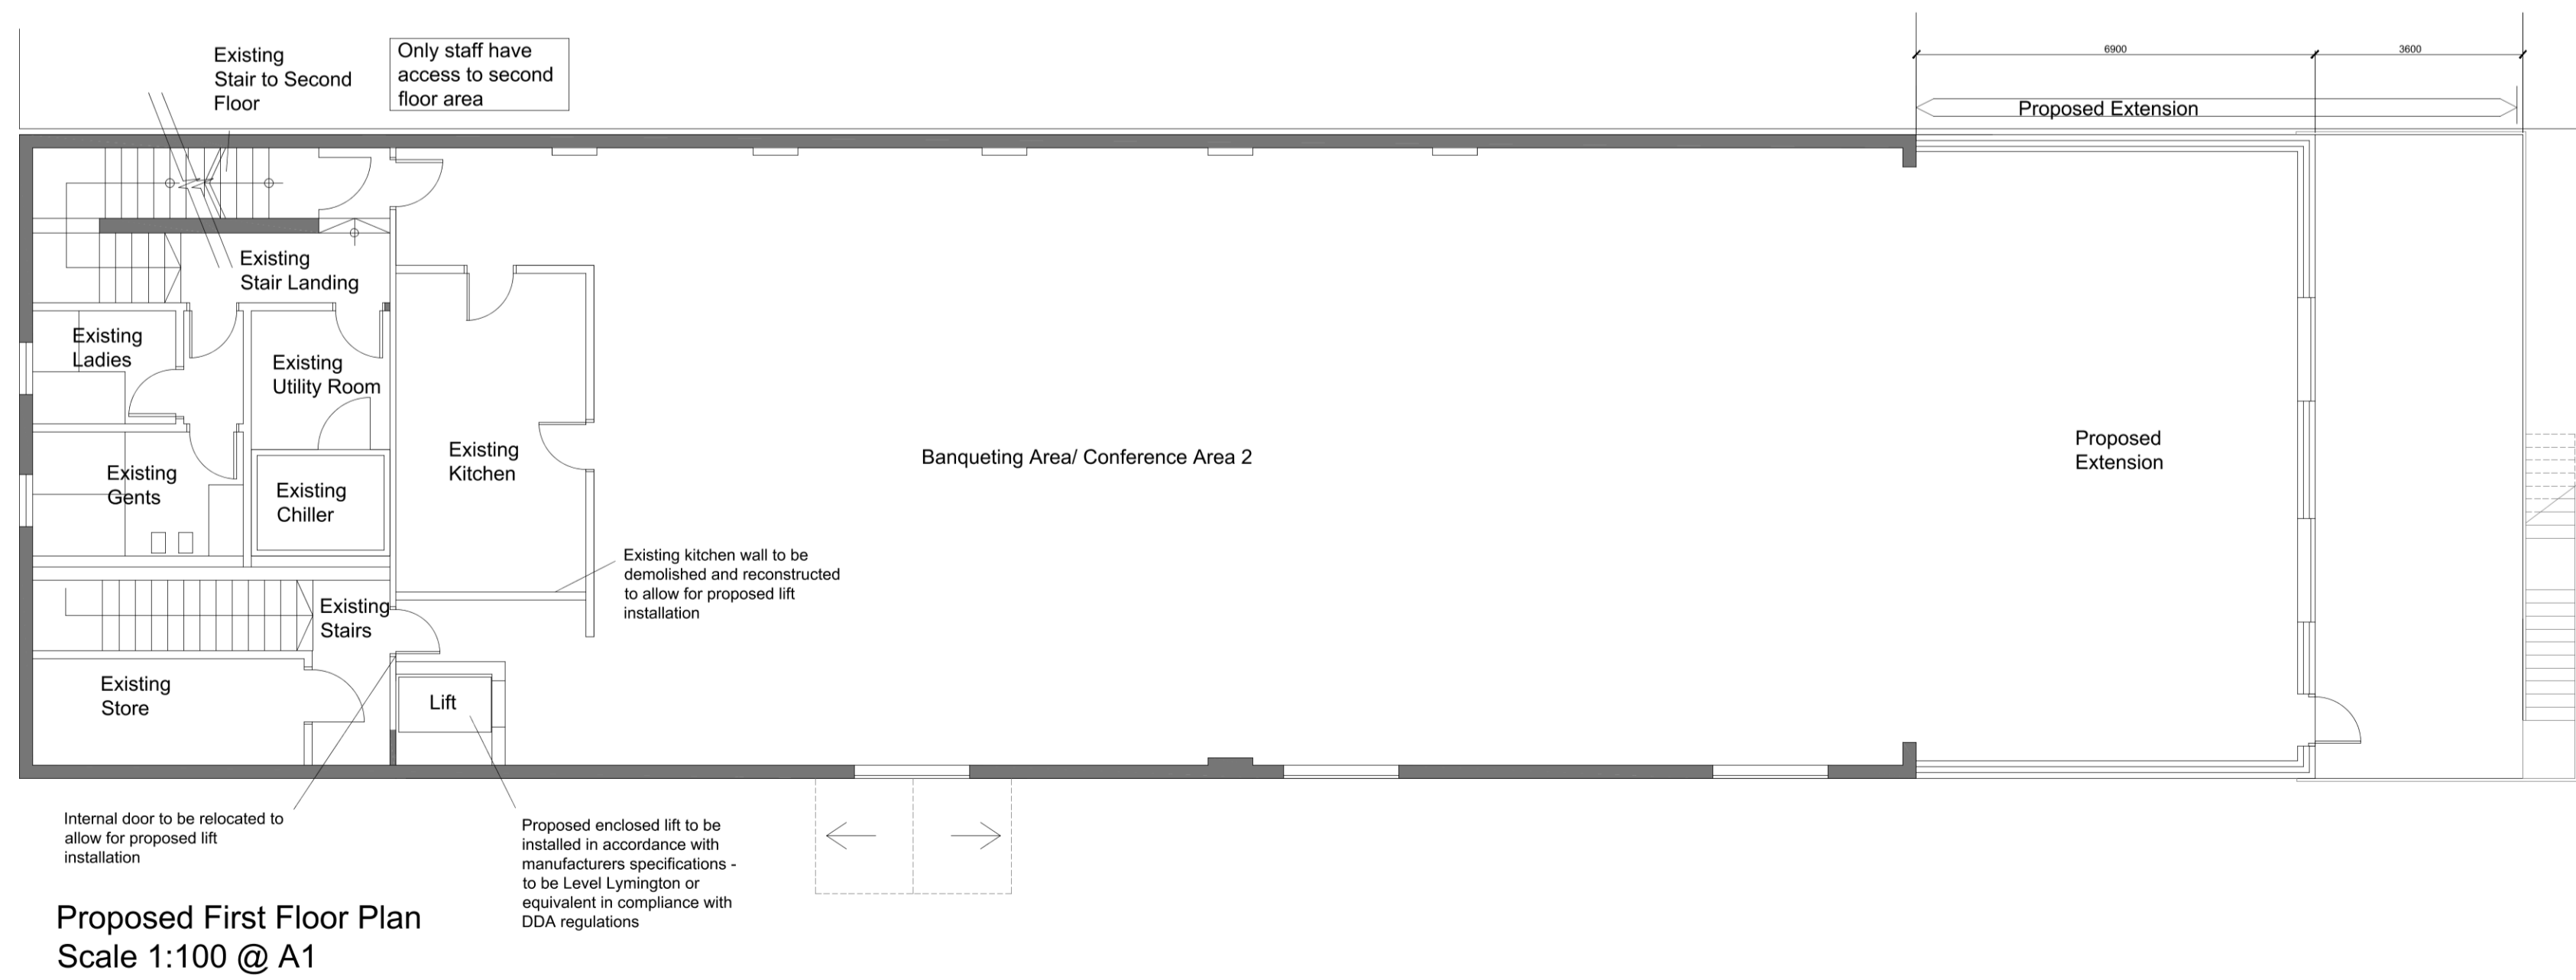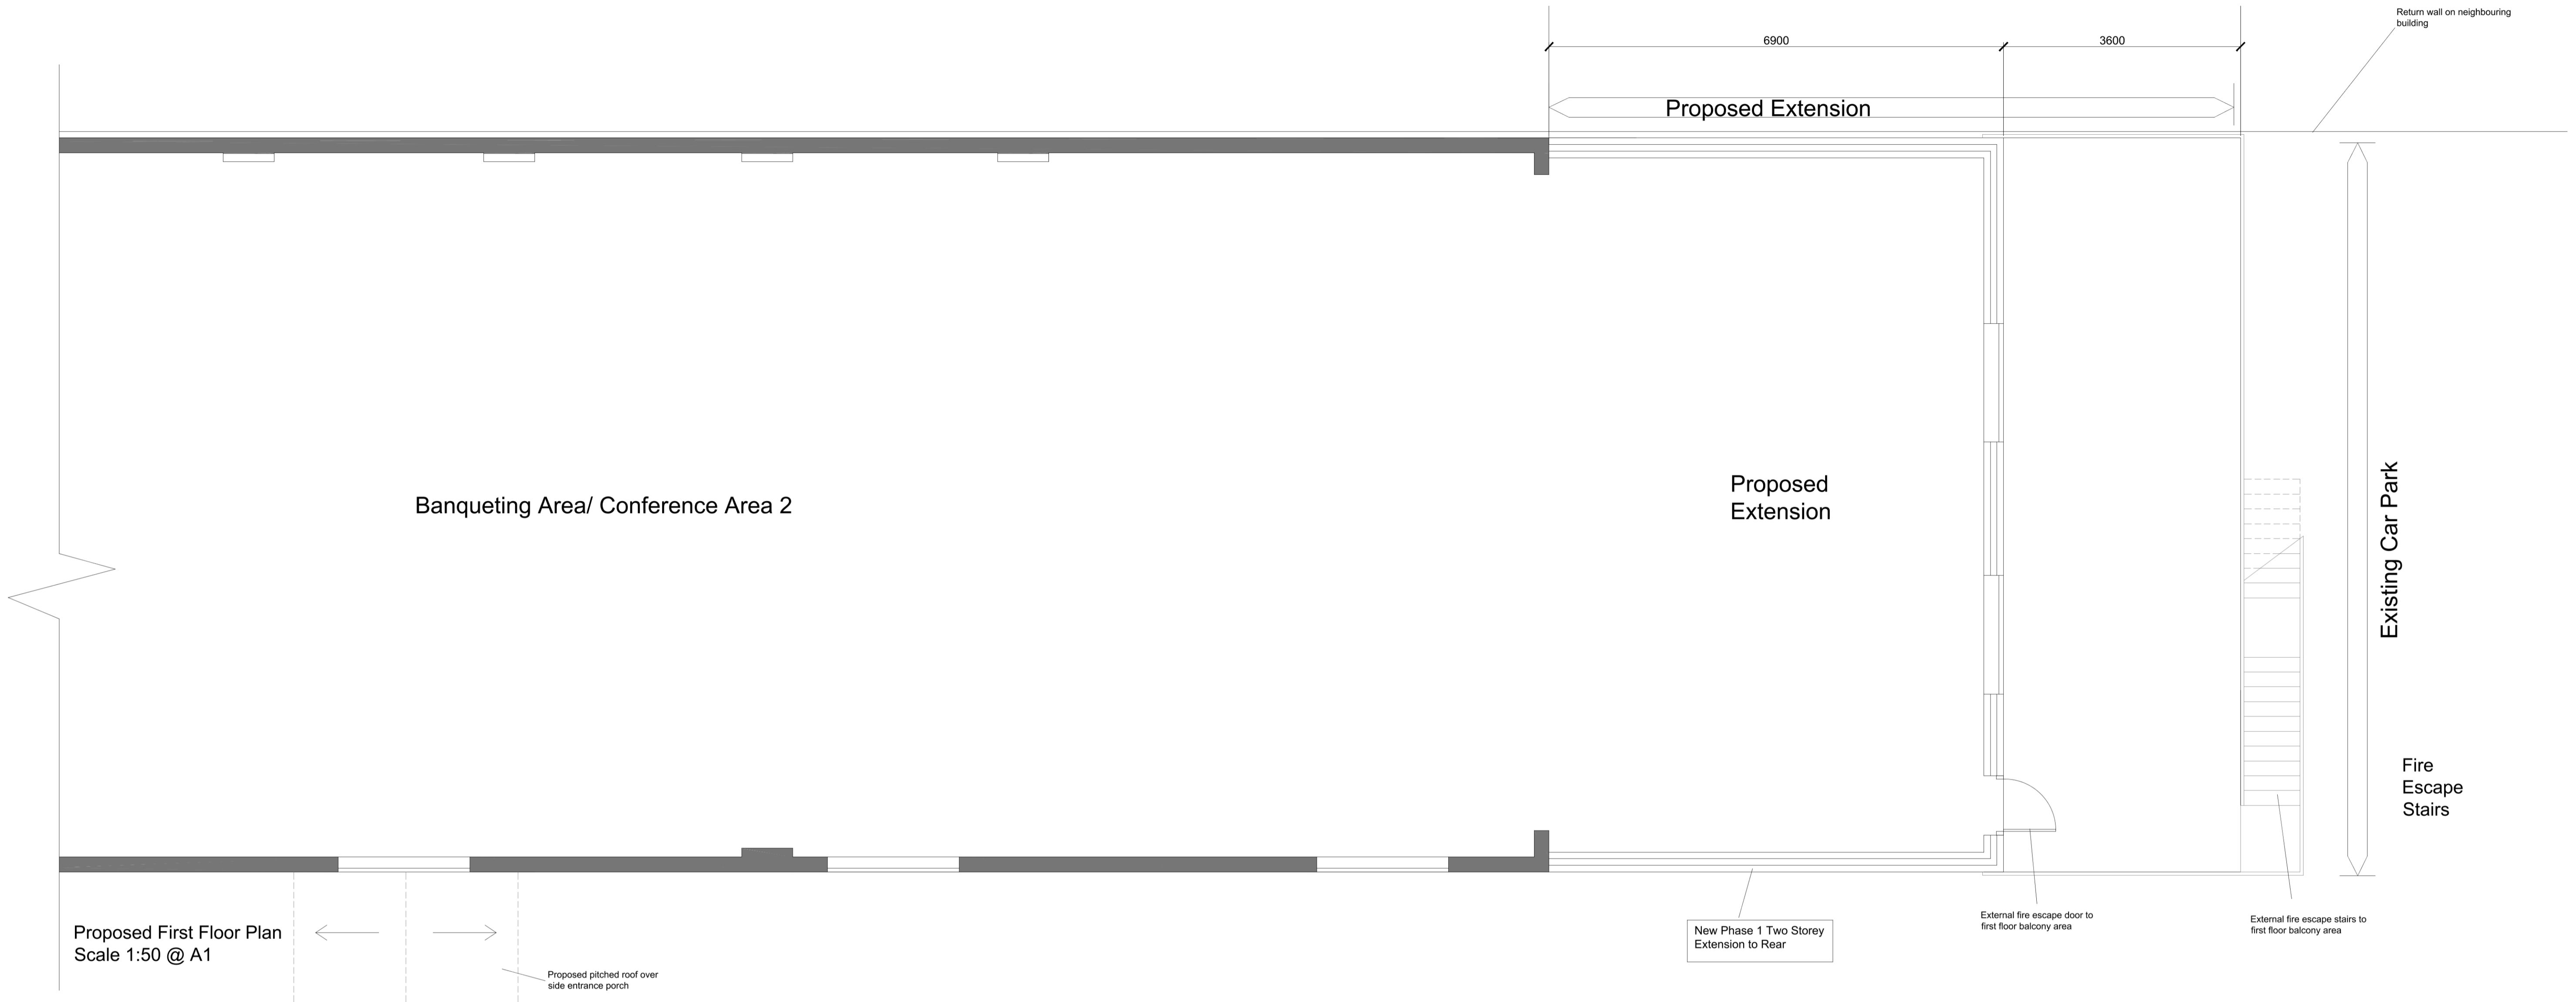


## AS BUILT RETROSPECTIVE PLANNING SUBMISSION

revn	date	by	chckd
cdrb architects ltd 8 The Square Kenilworth CV8 1EB			
job title Extension and Change of Use to Banqueting Suite/Conference Centre, Boundary Wall and Railings and Change of Use of Public Amenity Space to Car Parking at 11 to 12 King William Street, Coventry, CV1 5JD			
drawing title Proposed First Floor Plan			
scale	drawn by	date	checked by
1:50 & 1:100 @A1	TP	June 2017	CDR
job no.	drawing no.	revision	
T1016	AL (P) 05	-	


**GENERAL NOTES**

DRAWING CAN BE SCALED FOR PLANNING PURPOSES ONLY BUT IF IN ANY DOUBT ABOUT A DIMENSION OR ANY OF THE DRAWN INFORMATION PLEASE ASK CDRB ARCHITECTS.

11 to 12 KING WILLIAM STREET, COVENTRY

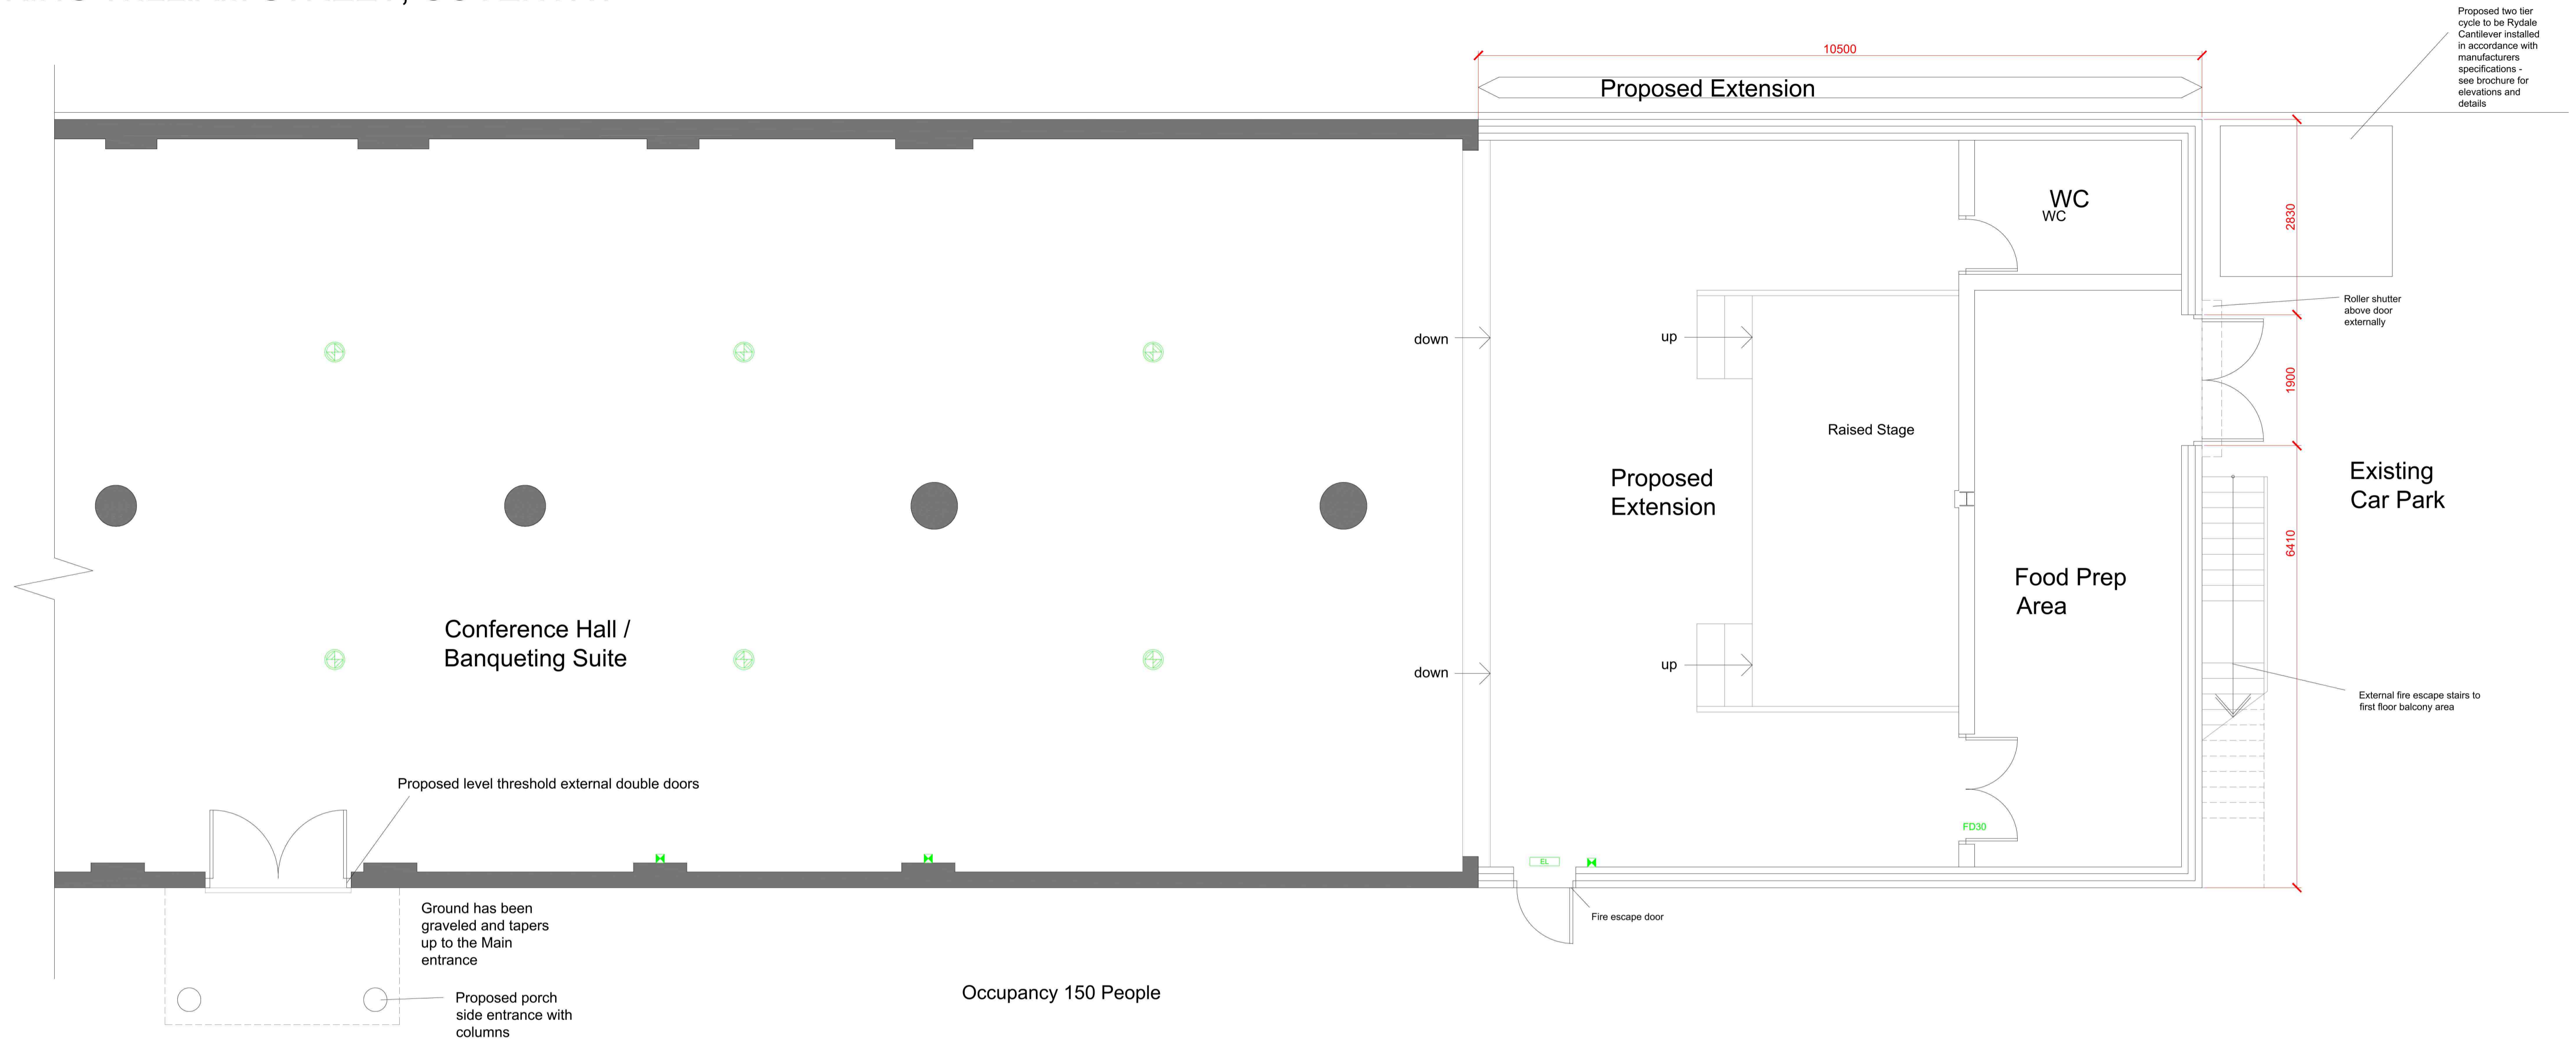

As Built Ground Floor Plan  
Scale 1:50 @ A1

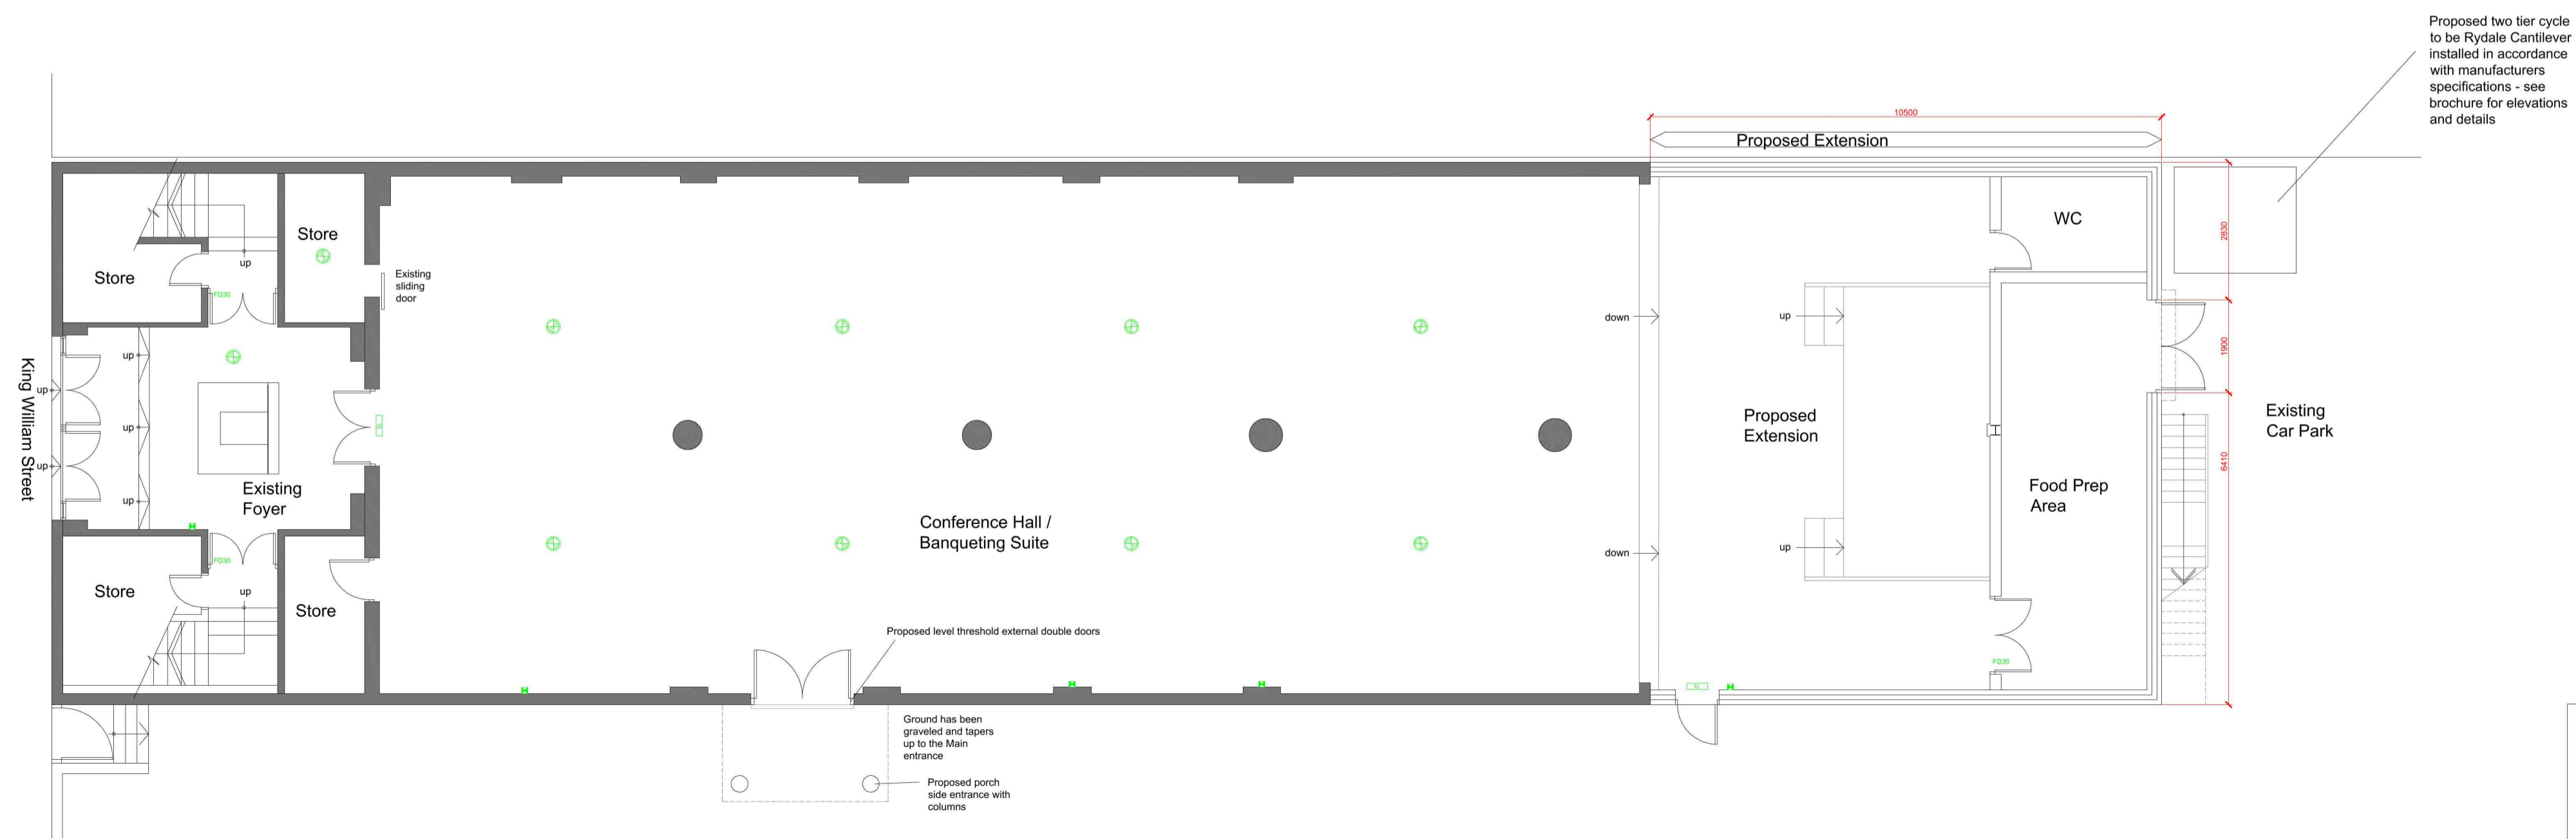


As Built Ground Floor Plan  
Scale 1:100 @ A1

**GENERAL NOTES**  
DRAWING CAN BE SCALED FOR PLANNING PURPOSES ONLY BUT IF IN ANY DOUBT ABOUT A DIMENSION OR ANY OF THE DRAWN INFORMATION PLEASE ASK CDRB ARCHITECTS.


AS BUILT RETROSPECTIVE PLANNING SUBMISSION

revn	date	by	chckd
cdrb architects ltd 8 The Square Kenilworth CV8 1EB			
Job title Extension and Change of Use to Banqueting Suite/Conference Centre, Boundary Wall and Railings and Change of Use of Public Amenity Space to Car Parking at 11 to 12 King William Street, Coventry, CV1 5JD			
drawing title Proposed Ground Floor Plan			
scale	drawn by	date	checked by
1:50 & 1:100 @A1	TP	June 2017	CDRB
job no.	drawing no.	revision	
T1016	AL (P) 04	-	


**GENERAL NOTES**  
 DRAWING CAN BE SCALED FOR PLANNING PURPOSES ONLY BUT IF IN ANY DOUBT ABOUT A DIMENSION OR ANY OF THE DRAWN INFORMATION PLEASE ASK CDRB ARCHITECTS.

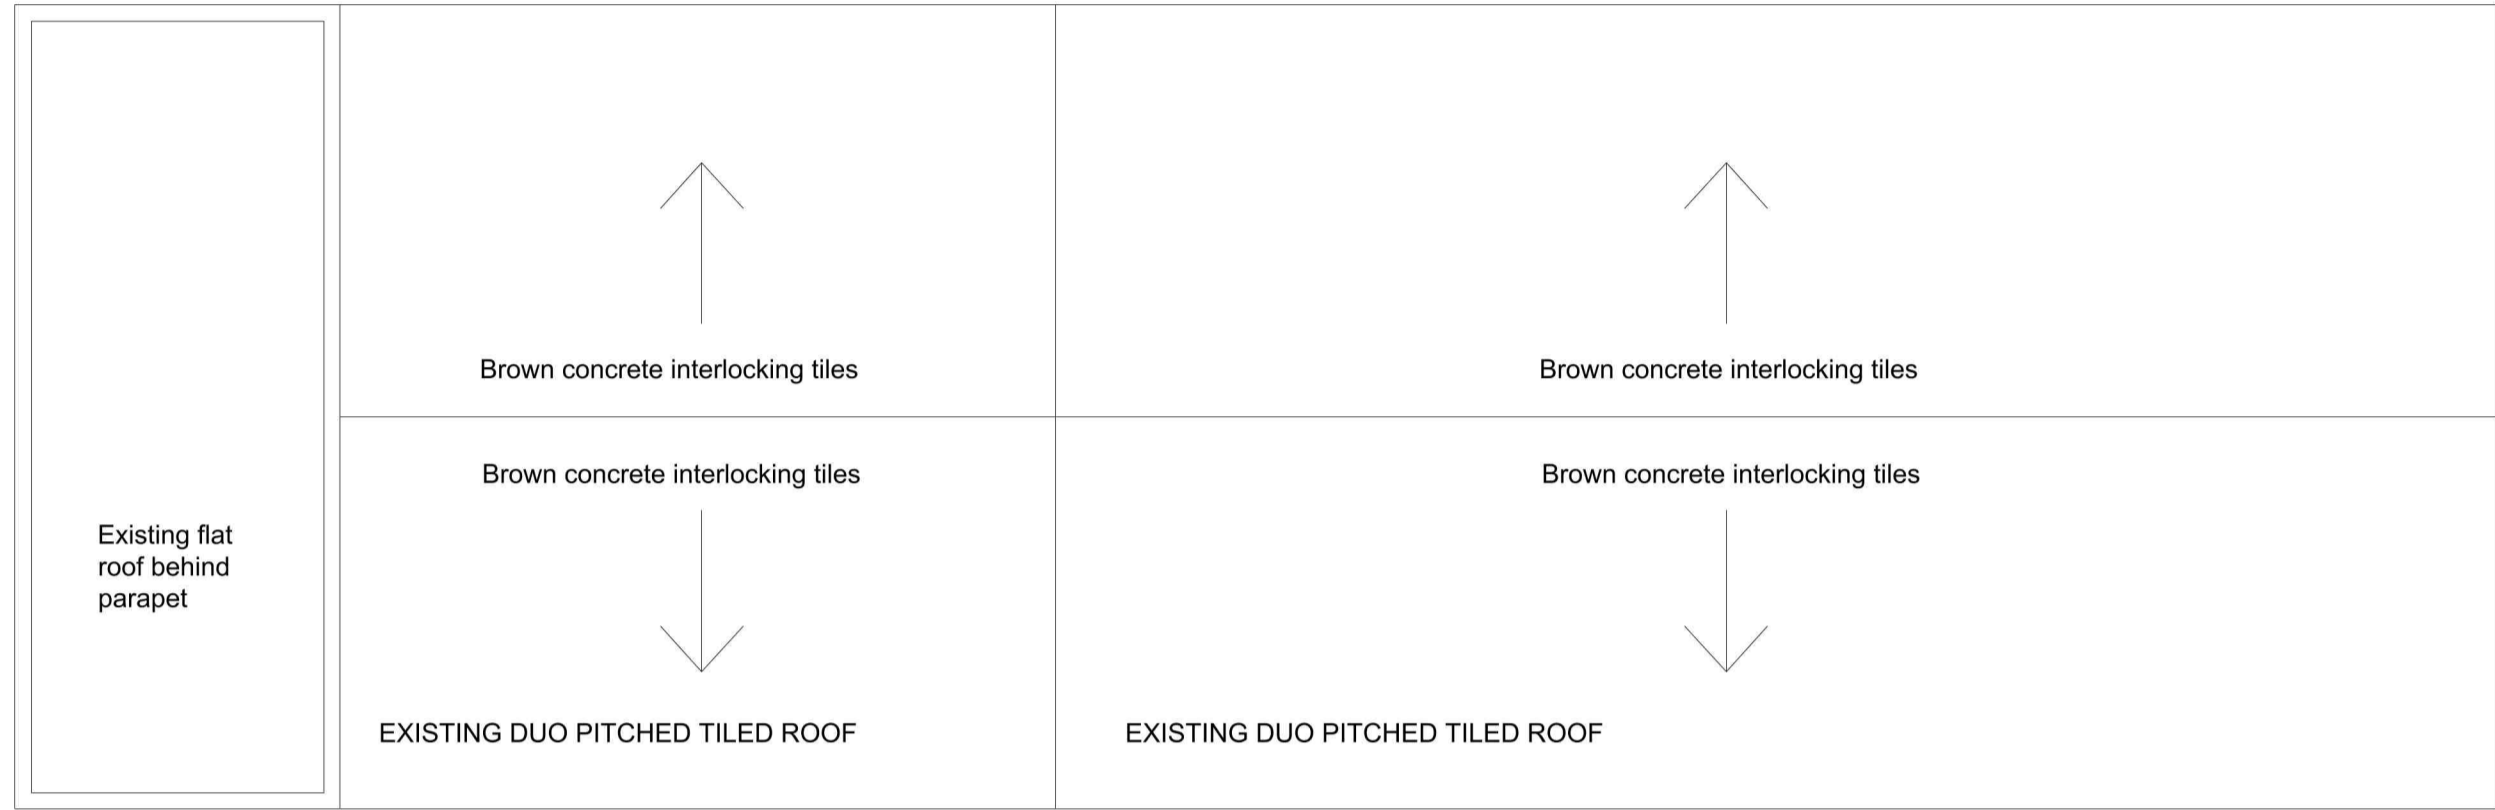

Existing Roof Plan.  
 Scale 1:100 @ A1

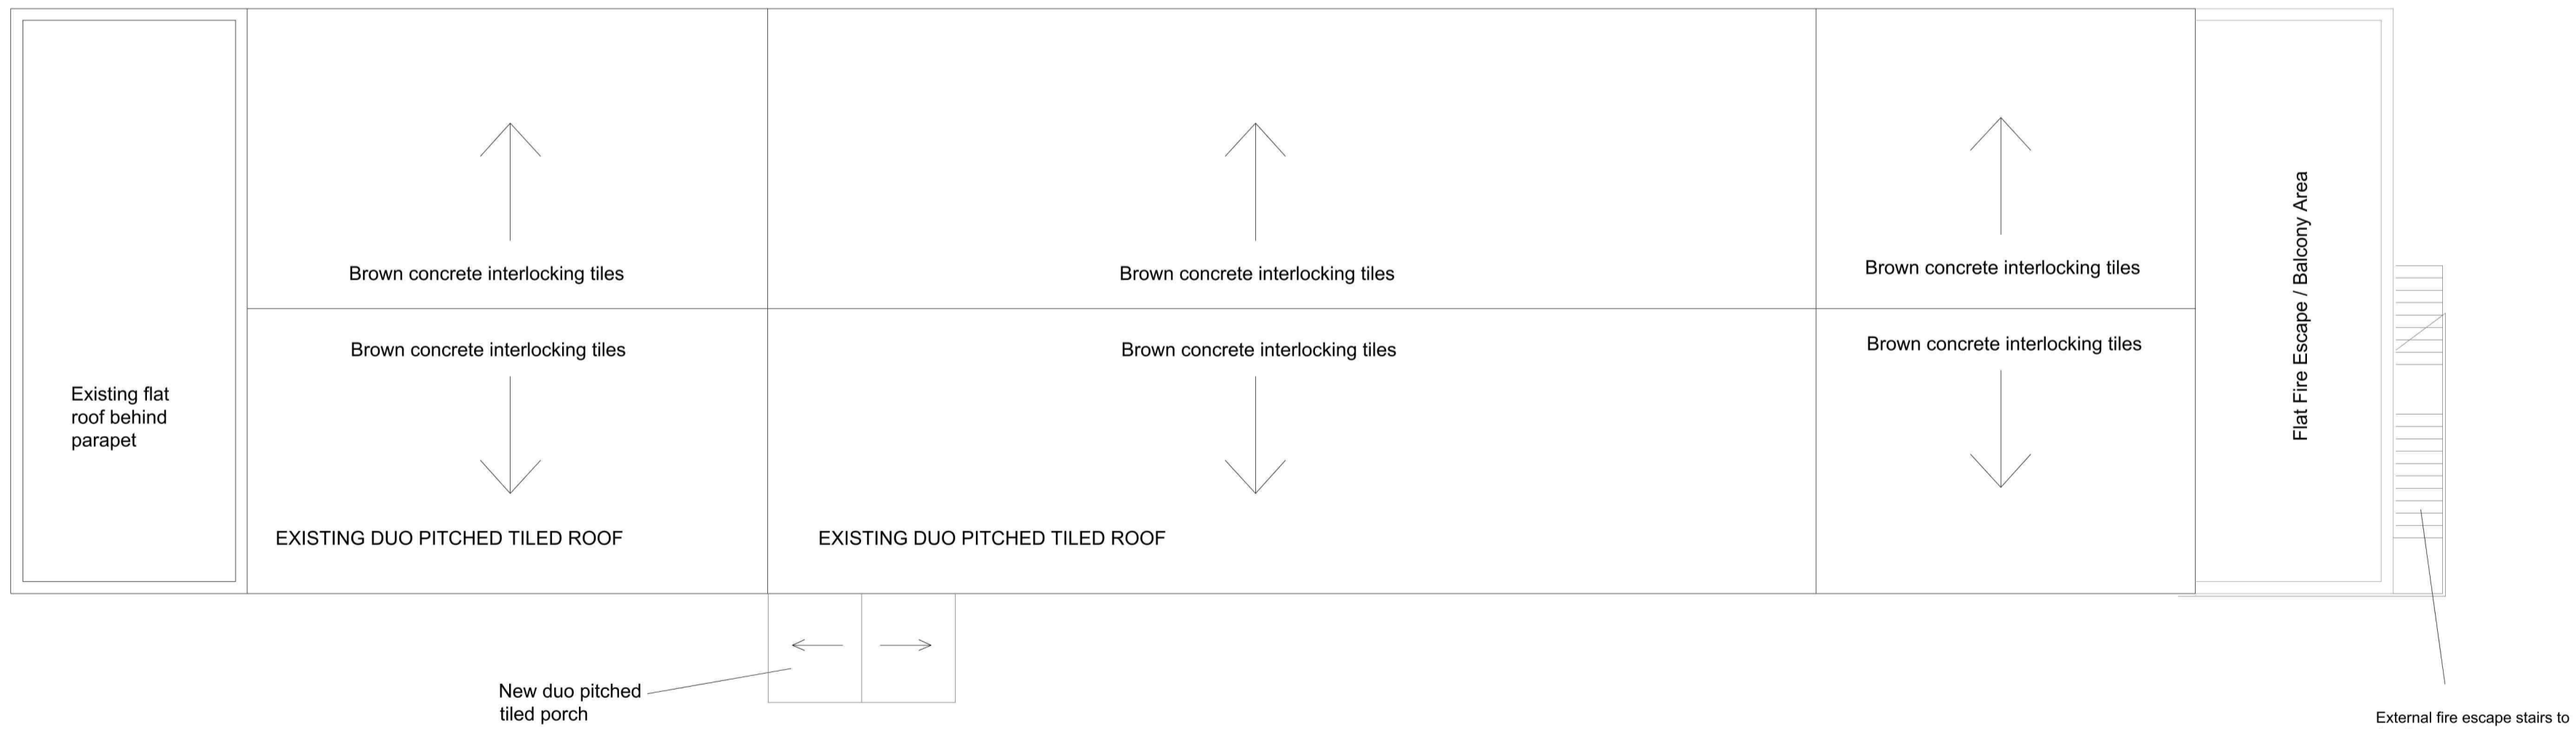

Proposed Roof Plan.  
 Scale 1:100 @ A1

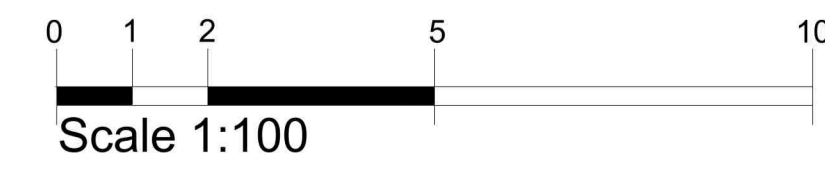

**AS BUILT RETROSPECTIVE PLANNING SUBMISSION**

revn	date	by	chkd
 <b>cdrb architects ltd</b> 8 Berkeley House, The Square, Warwick CV8 1EB			
job title			
Extension and Change of Use to Banqueting Suite/Conference Centre, Boundary Wall and Railings and Change of Use of Public Amenity Space to Car Parking at 11 to 12 King William Street, Coventry, CV1 5JD			
drawing title			
Existing + Proposed Roof Plan			
scale	drawn by	date	checked by
1:100 @ A1	TP	June 2017	CDR
job no.	drawing no.	revision	
T1016	AL (P) 03	-	