



GENERAL NOTES
 DRAWING CAN BE SCALED FOR PLANNING PURPOSES ONLY BUT IF IN ANY DOUBT ABOUT A DIMENSION OR ANY OF THE DRAWN INFORMATION PLEASE ASK CDRB ARCHITECTS LTD.

To Fir Tree Avenue

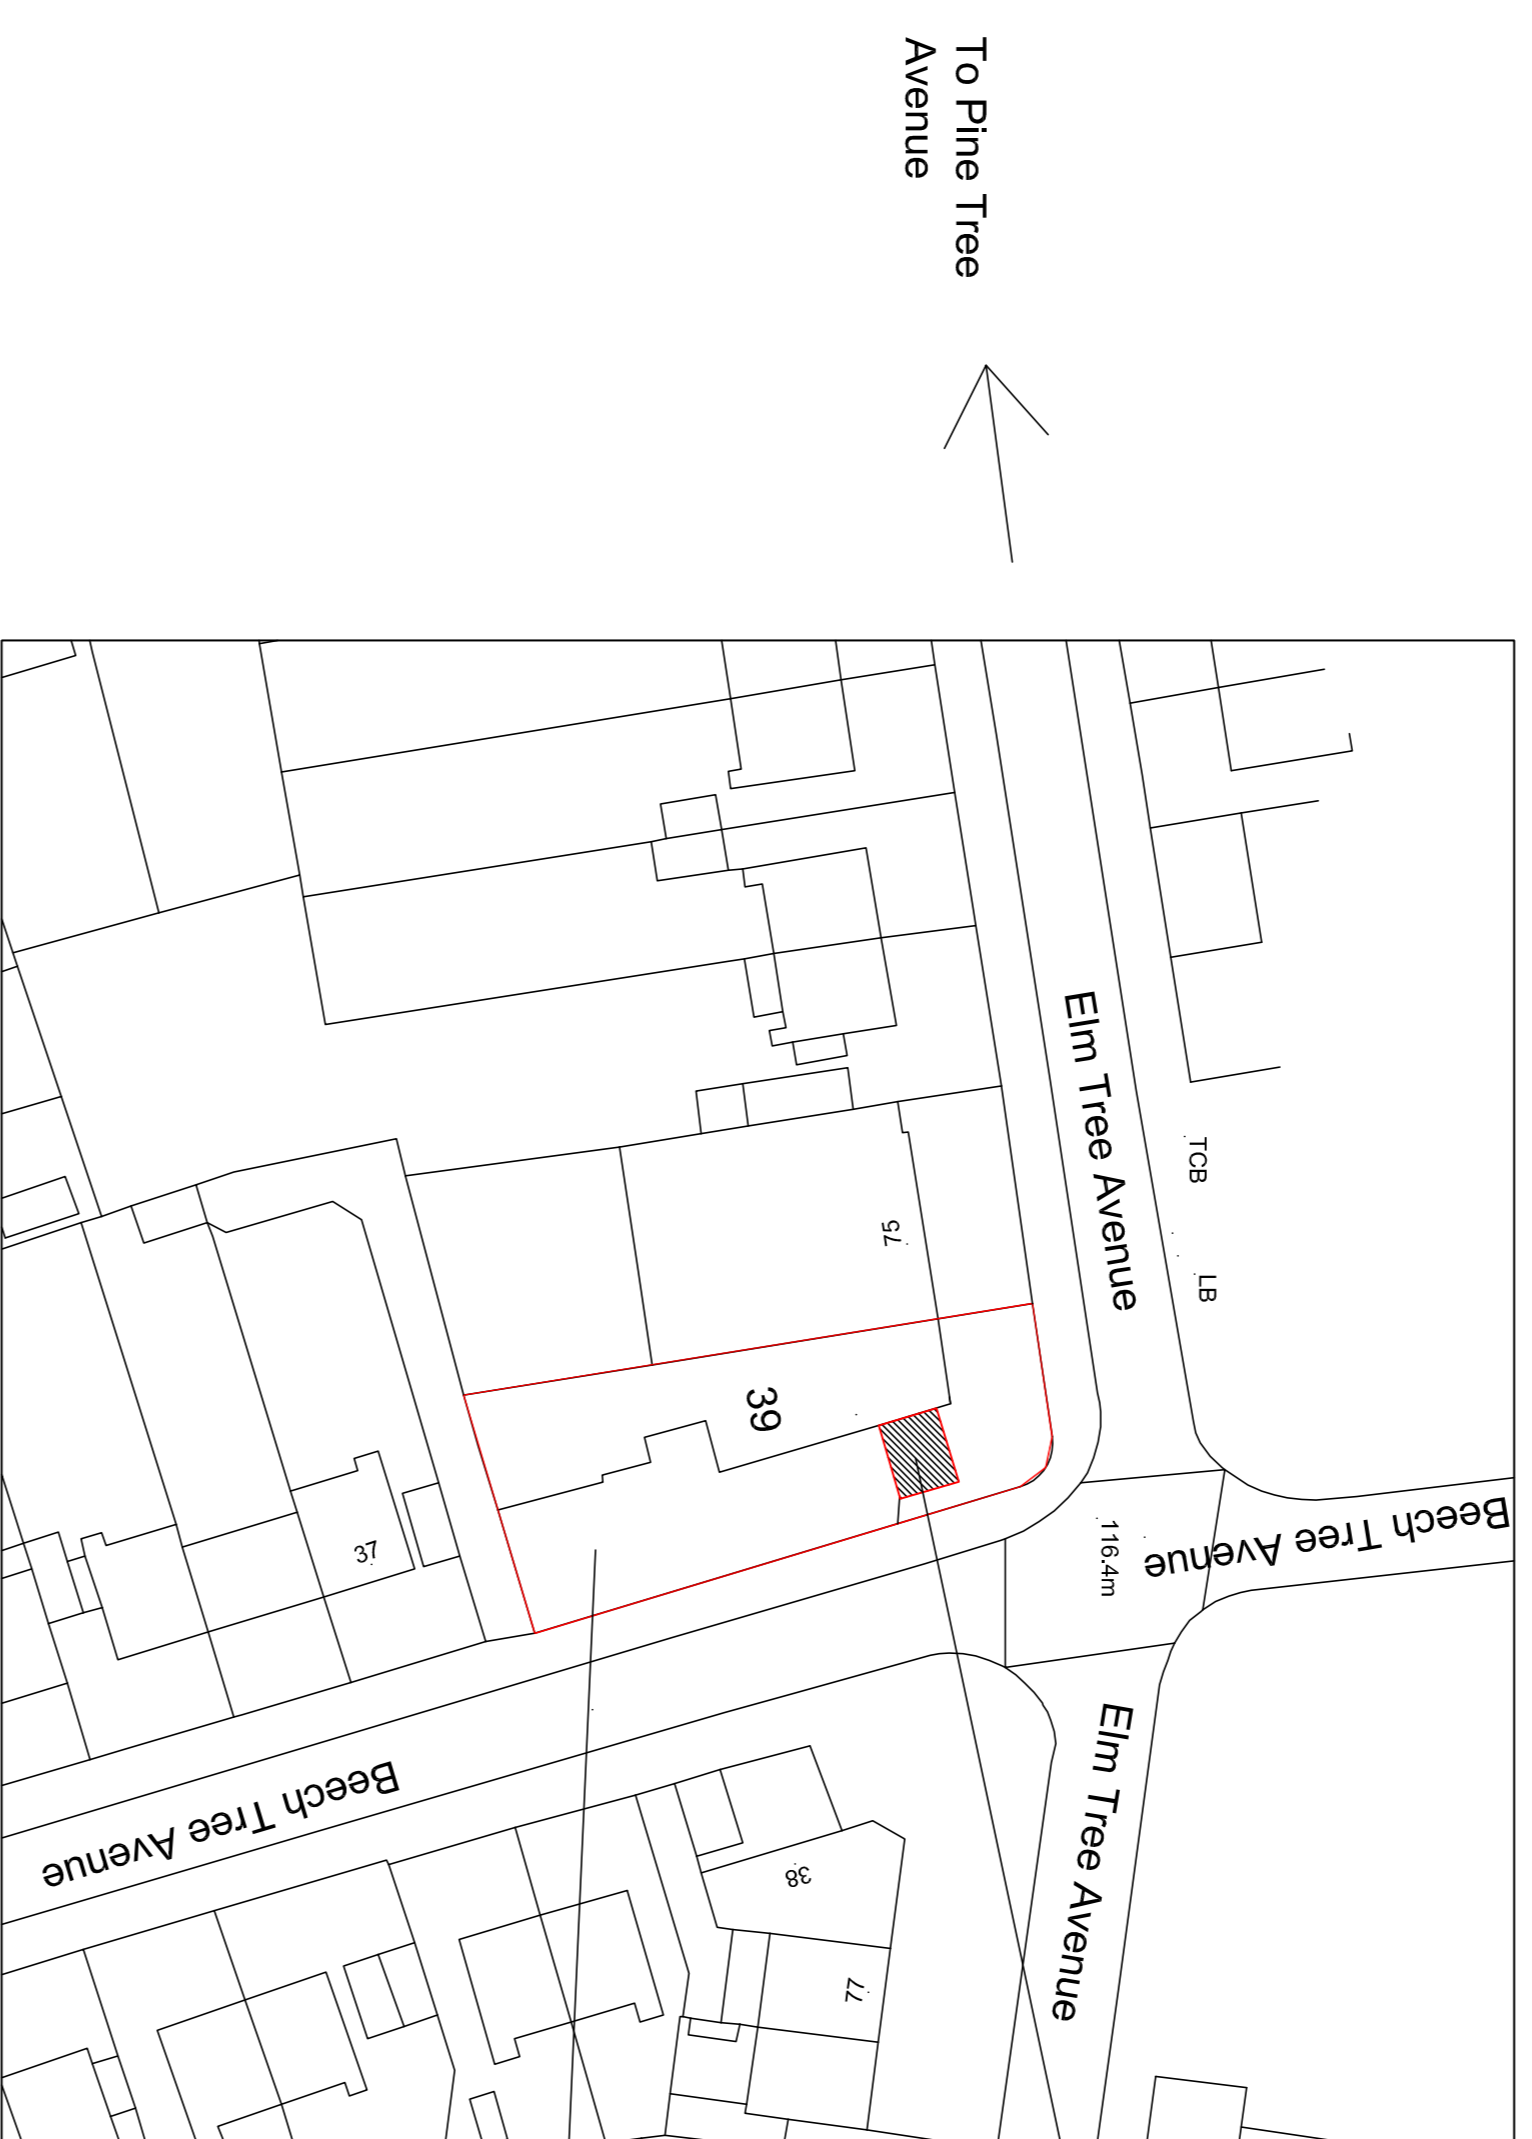


Customer Queing Shelter (due to Covid separation rules)
 To Dunchurch Highway (A46)


Proposed Site

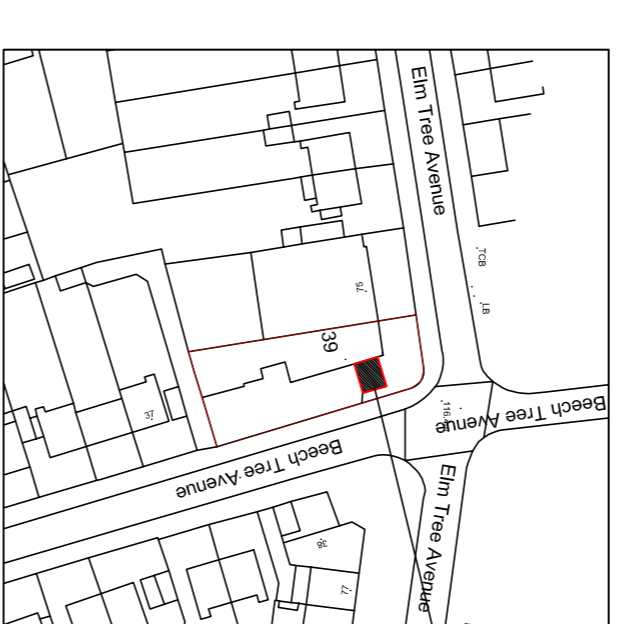


Customer Queing Shelter (due to Covid separation rules)

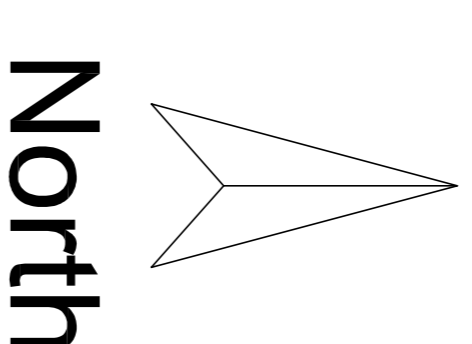


PLANNING SUBMISSION

room	date	by	checked by
 cddb architects ltd 100, Station Road, Coventry, CV3 9JG			
Job title			
Customer Queing Shelter (due to Covid separation rules) at 39 Beech Tree Avenue Coventry/ trading as Beech Tree Fish Bar			
drawing title			
Block Plan and Site Plan			
scale	drawn by	date	checked by
1:500 and 1:1250 @ A1	CR	June 2021	CDRB
job no	drawing no	revisions	
72218	AL/P/00		

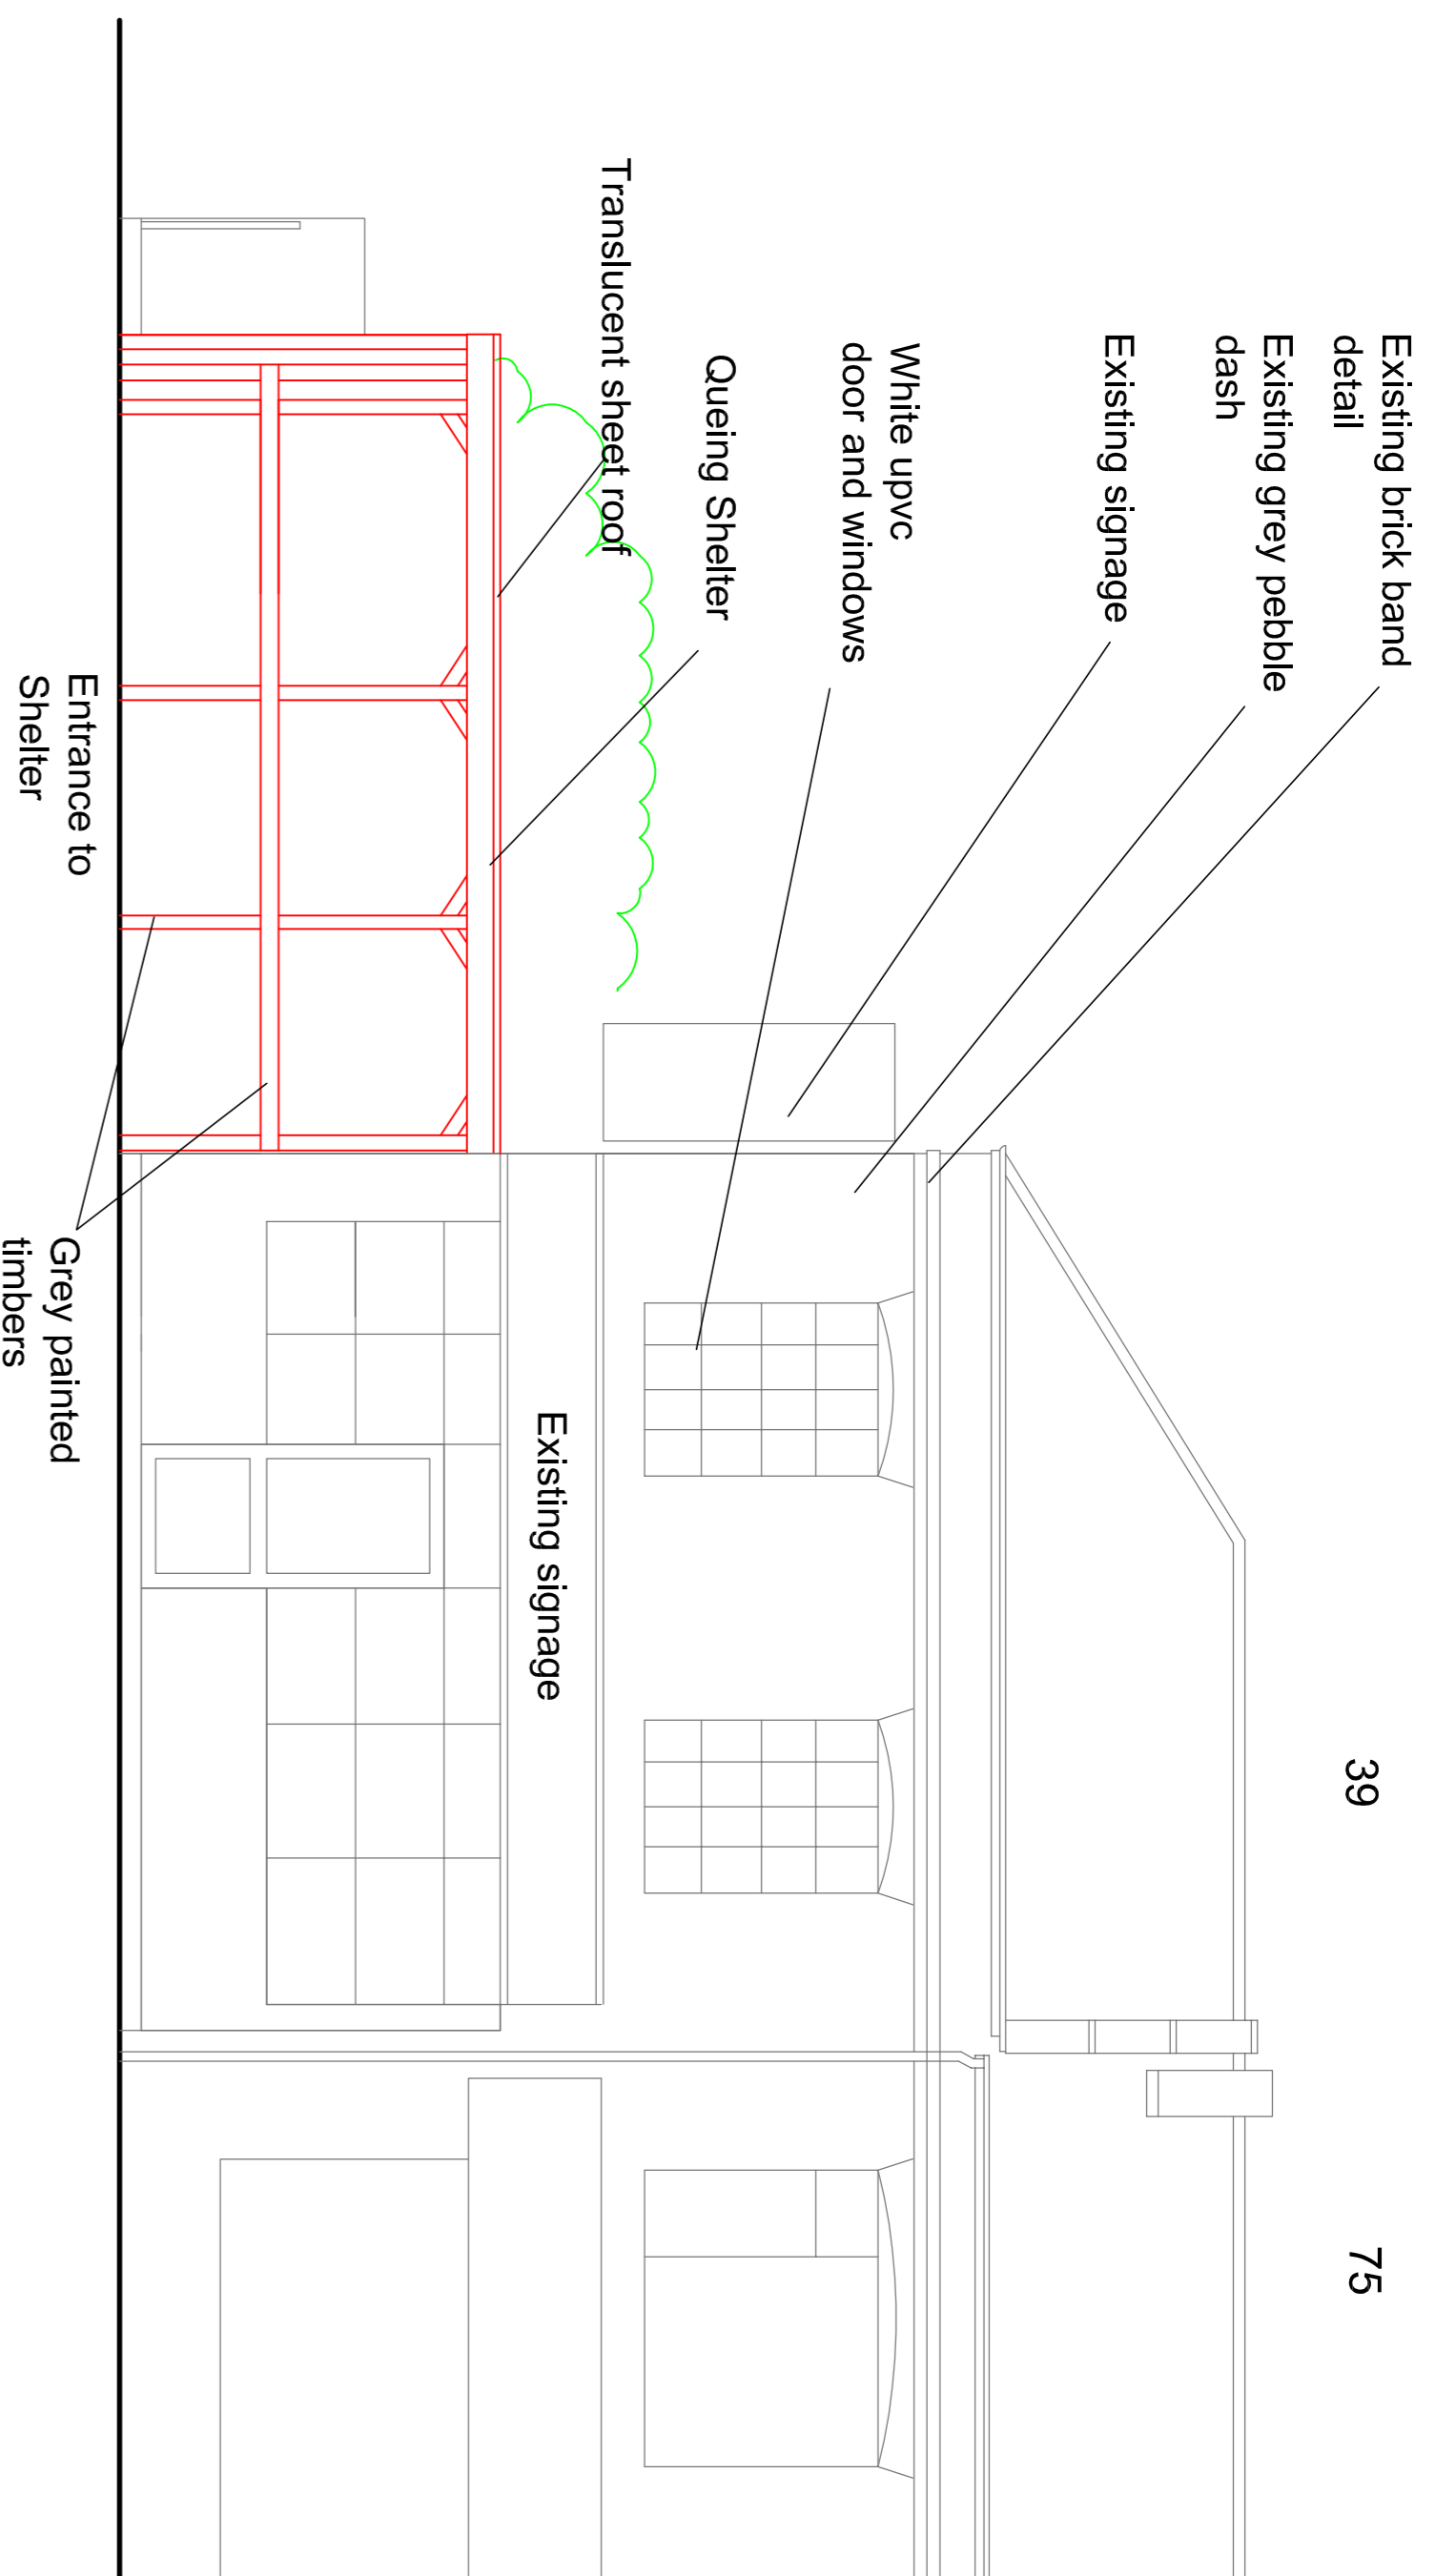


Side Elevation Facing Elm Tree Avenue
Scale 1:50 @ A1

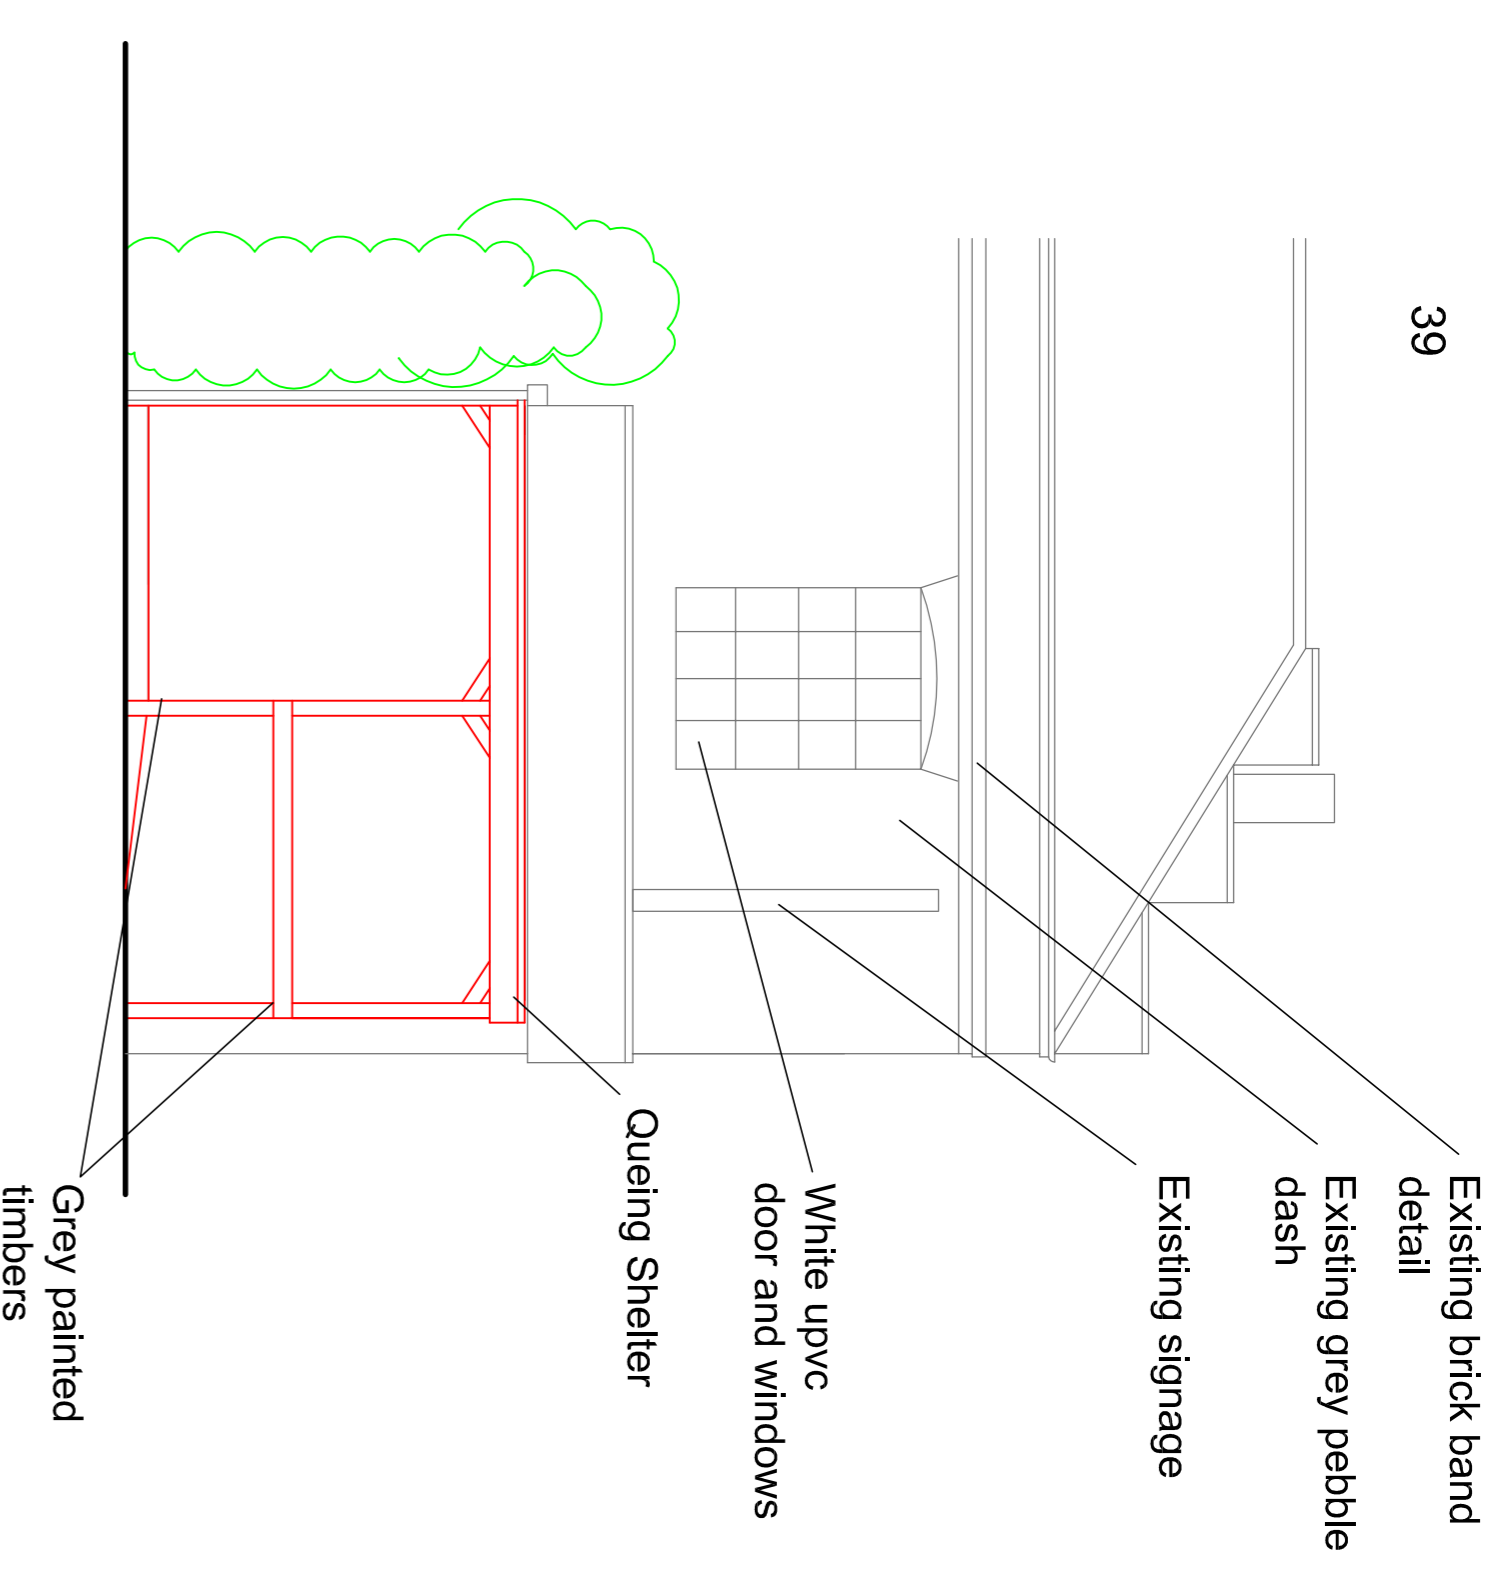


Side Elevation Facing Beech Tree Avenue
Scale 1:50 @ A1

GENERAL NOTES
DRAWING CAN BE SCALED FOR PLANNING PURPOSES ONLY BUT IF IN ANY DOUBT ABOUT A DIMENSION OR ANY OF THE DRAWING INFORMATION PLEASE ASK CDRB ARCHITECTS LTD.

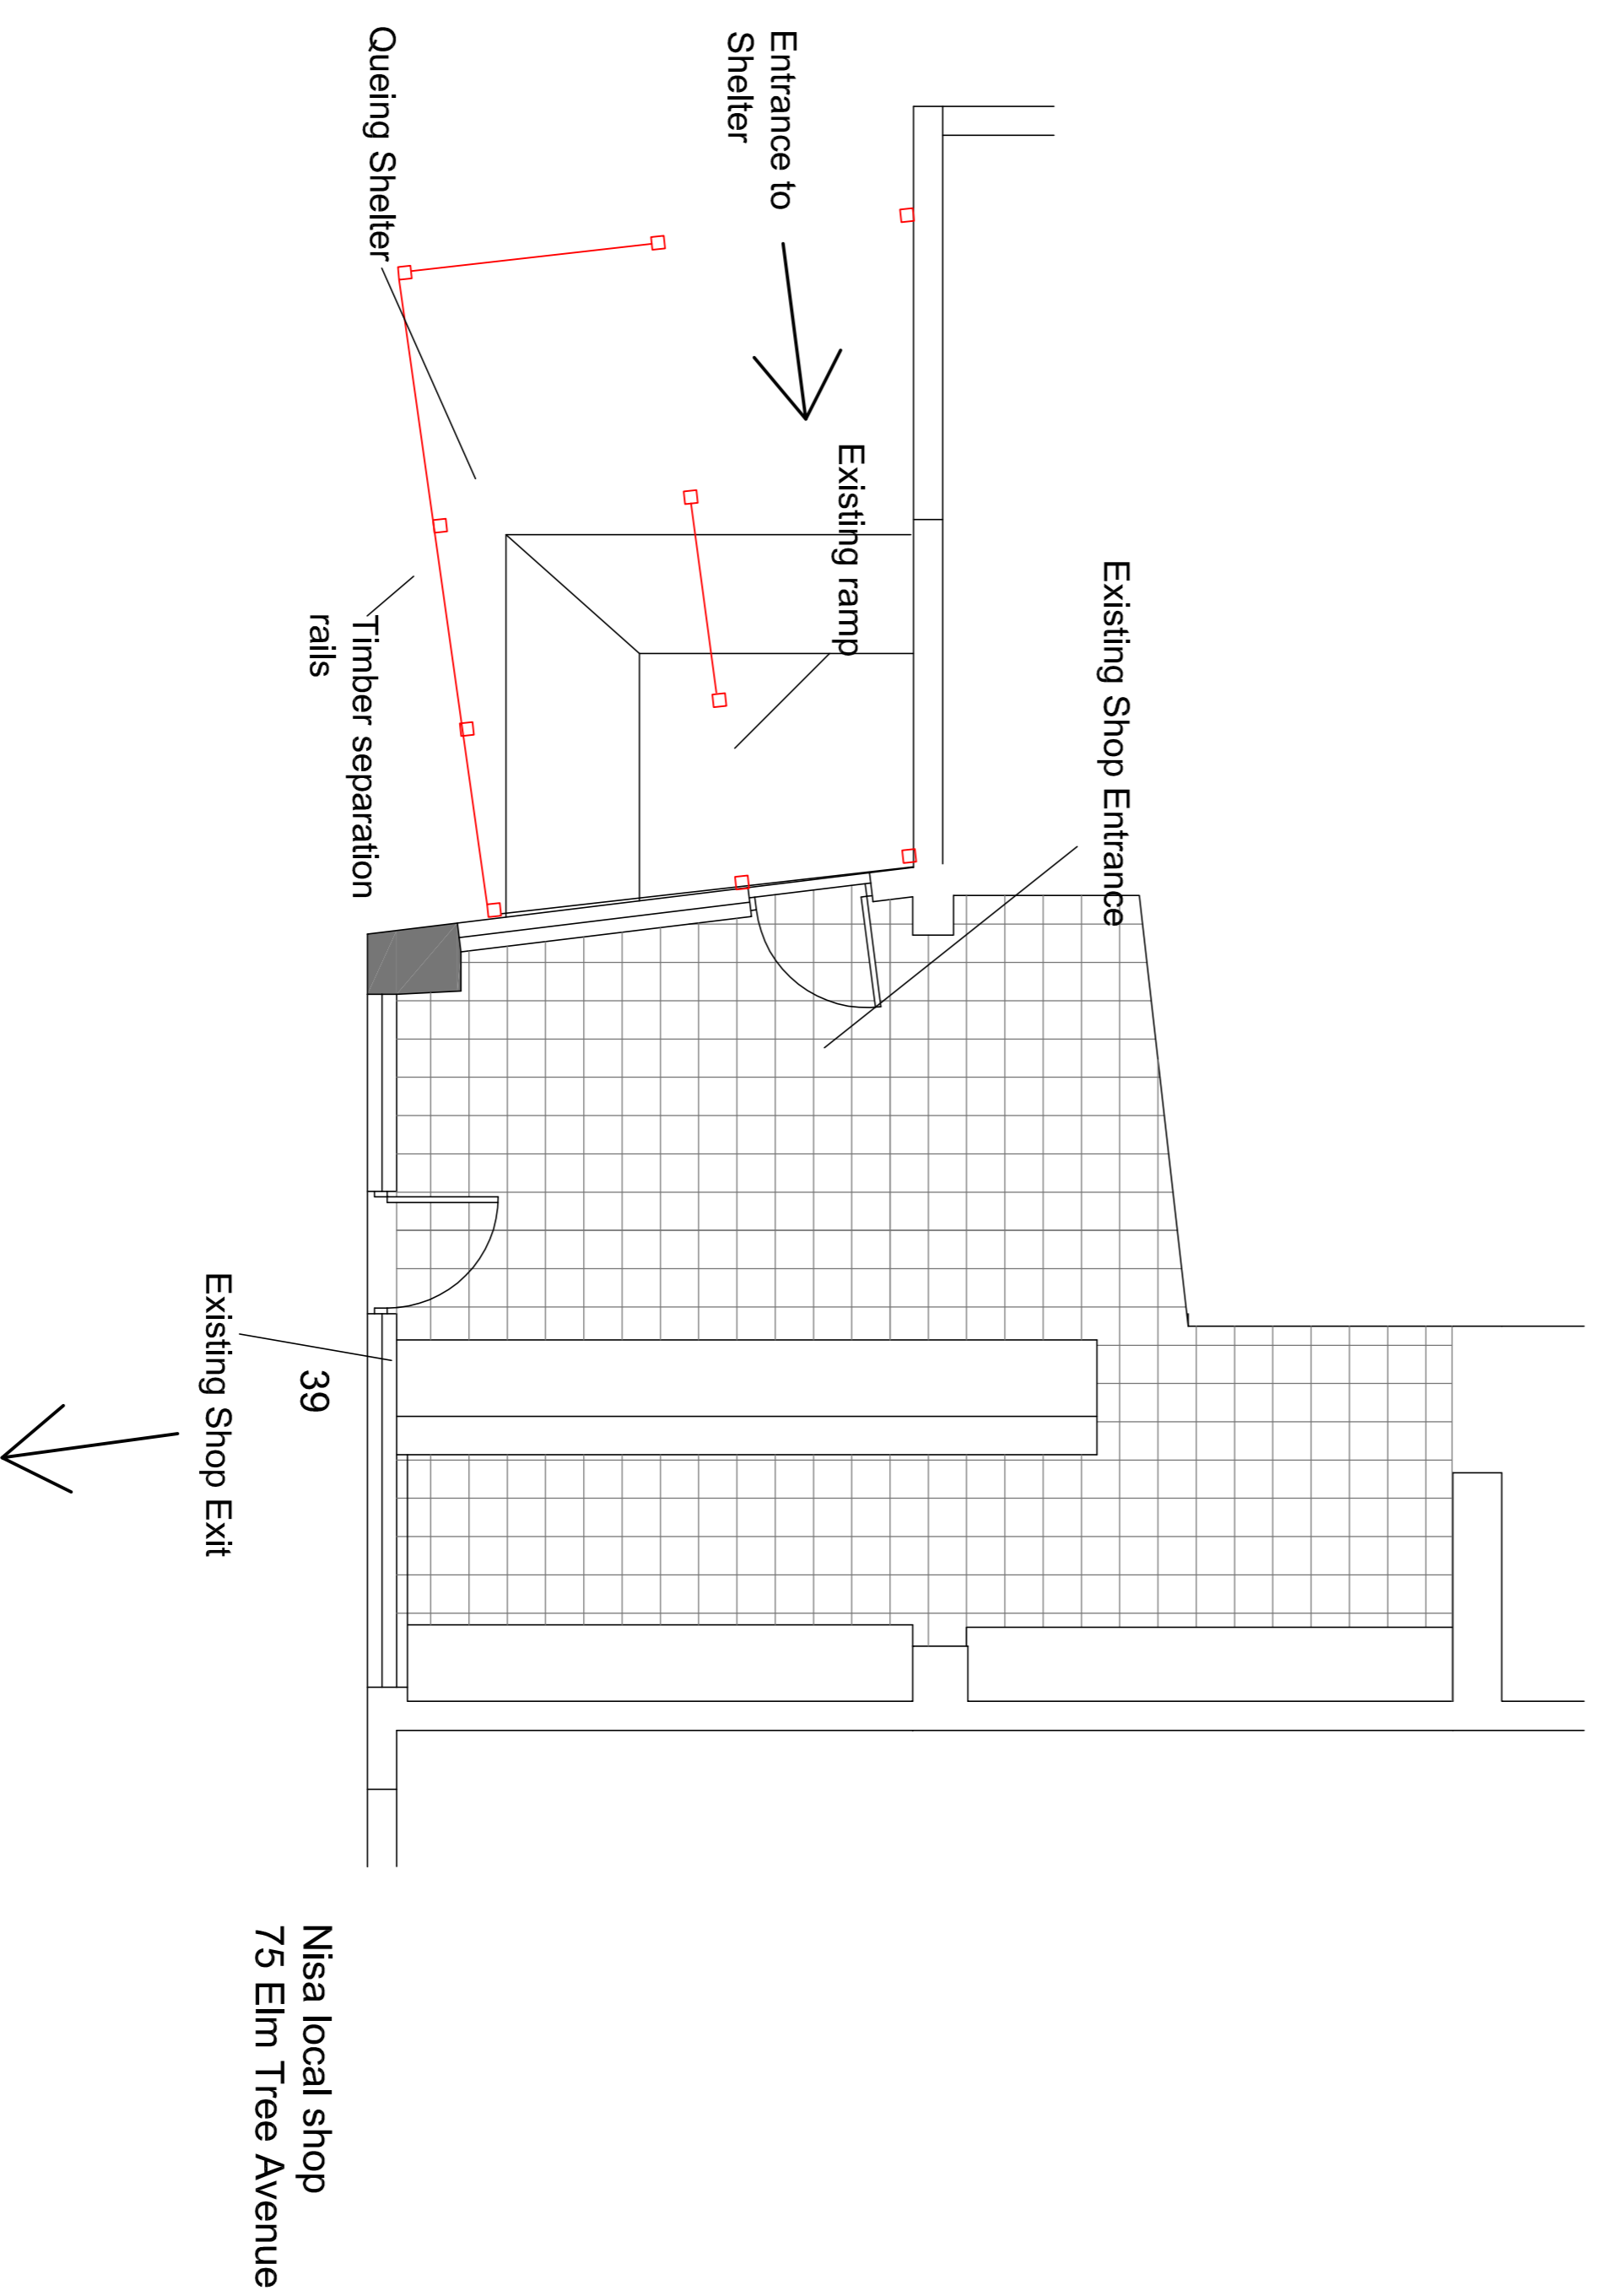


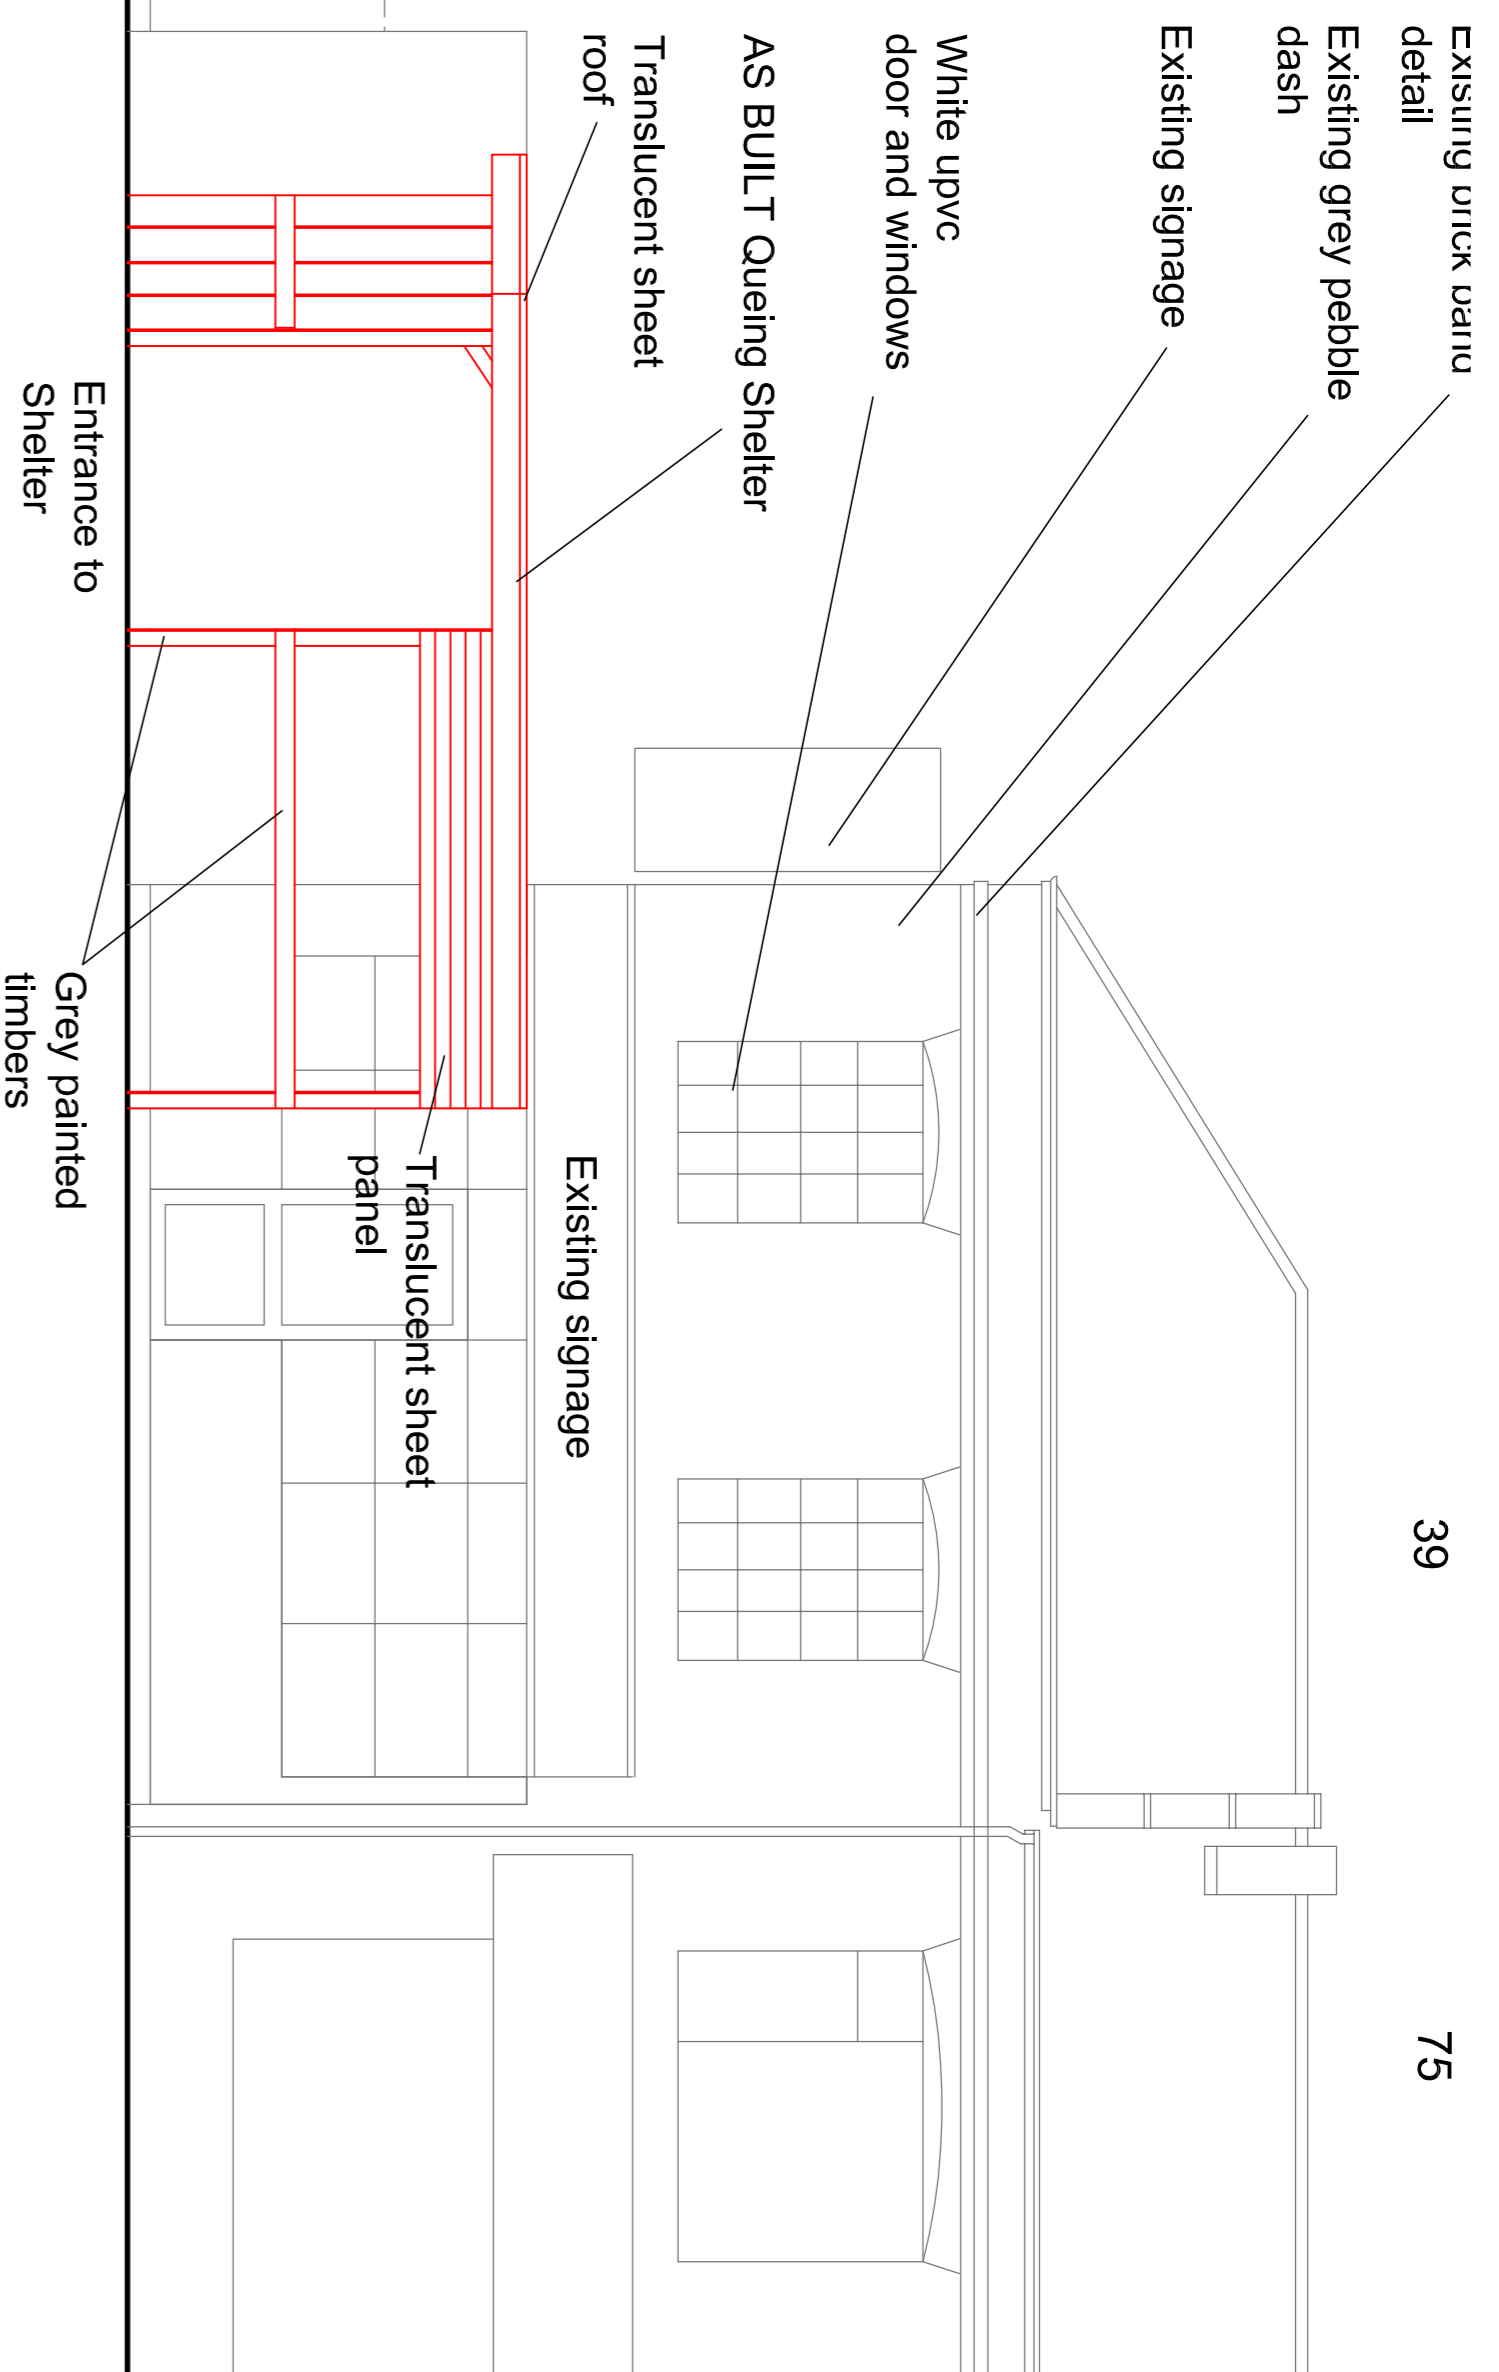
Nisa local shop
75 Elm Tree Avenue

Ground Floor Plan Showing External Queuing Shelter 50% Reduced in Size from Previous 'As Built' Structure
Scale 1:50 @ A1

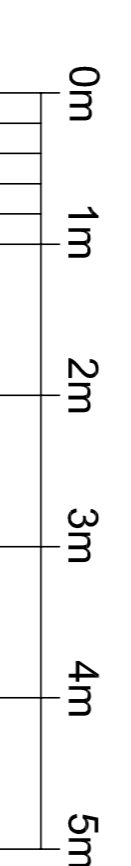


PLANNING SUBMISSION

room	date	drawn by	date	checked by
 cdrb architects ltd 01454 834000 39 Beech Tree Avenue COVENTRY CV3 9JG				
Job title Customer Queuing Shelter (due to Covid separation rules) at 39 Beech Tree Avenue Coventry/trading as Beech Tree Fish Bar				
drawing title Plans and Elevations				
scale	drawn by	date	checked by	
1:50 @ A1	CR	June 2021	CDRB	
job no.	drawing no.	revisions		
72218	AL/P/01			




AS BUILT Side Elevation Facing Elm Tree Avenue
Scale 1:50 @ A1

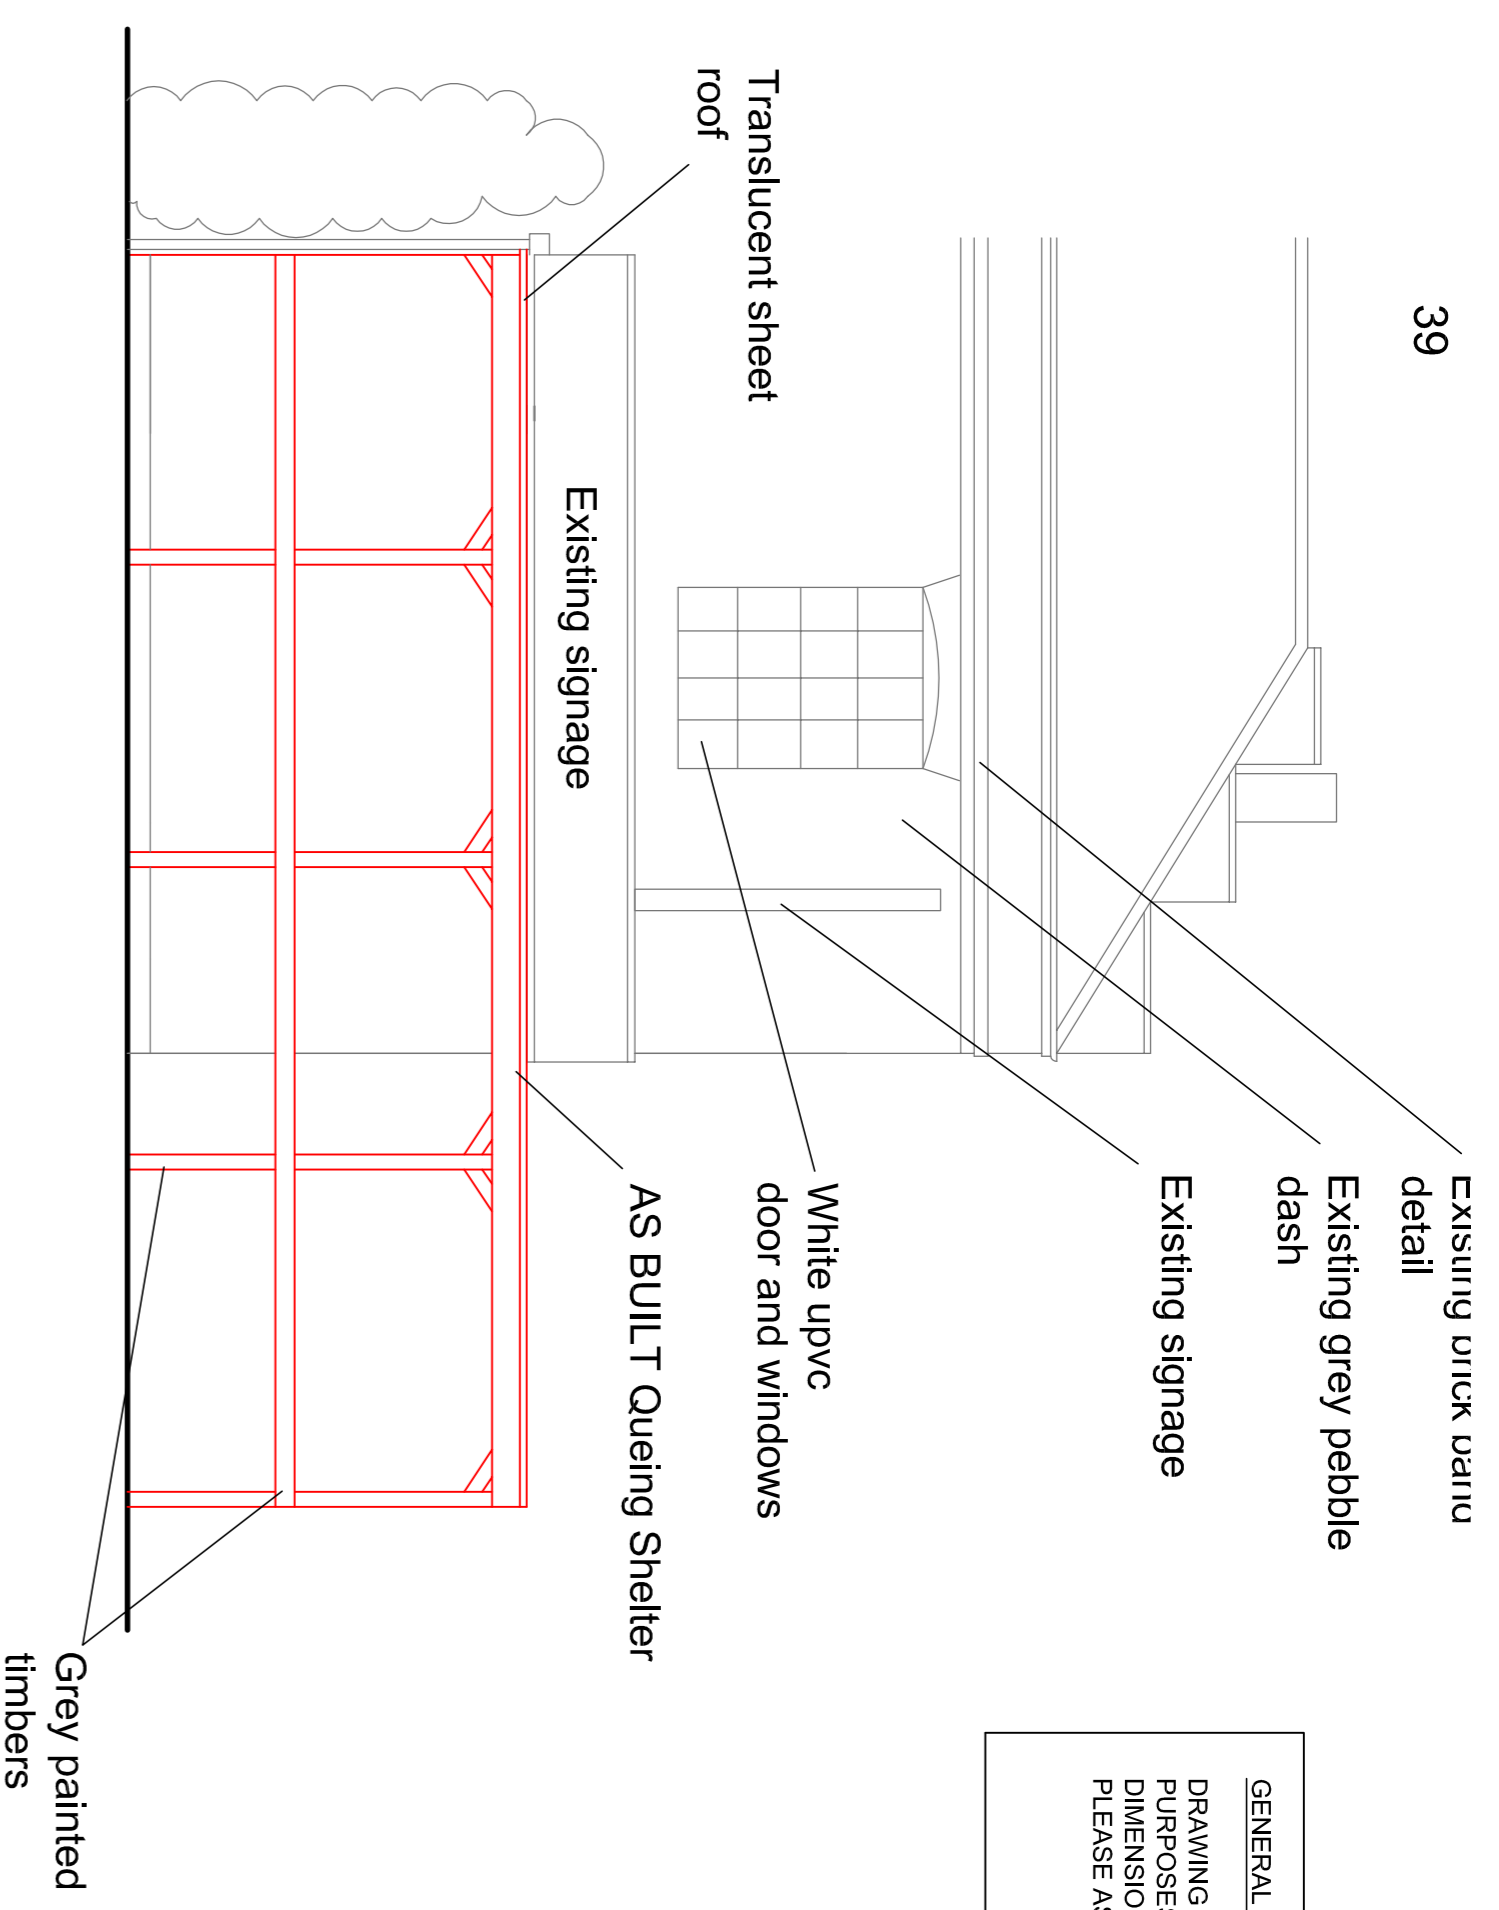


AS BUILT Side Elevation Facing Beech Tree Avenue
Scale 1:50 @ A1

GENERAL NOTES
DRAWING CAN BE SCALED FOR PLANNING PURPOSES ONLY BUT IF IN ANY DOUBT ABOUT A DIMENSION OR ANY OF THE DRAWN INFORMATION PLEASE ASK CDRB ARCHITECTS LTD.

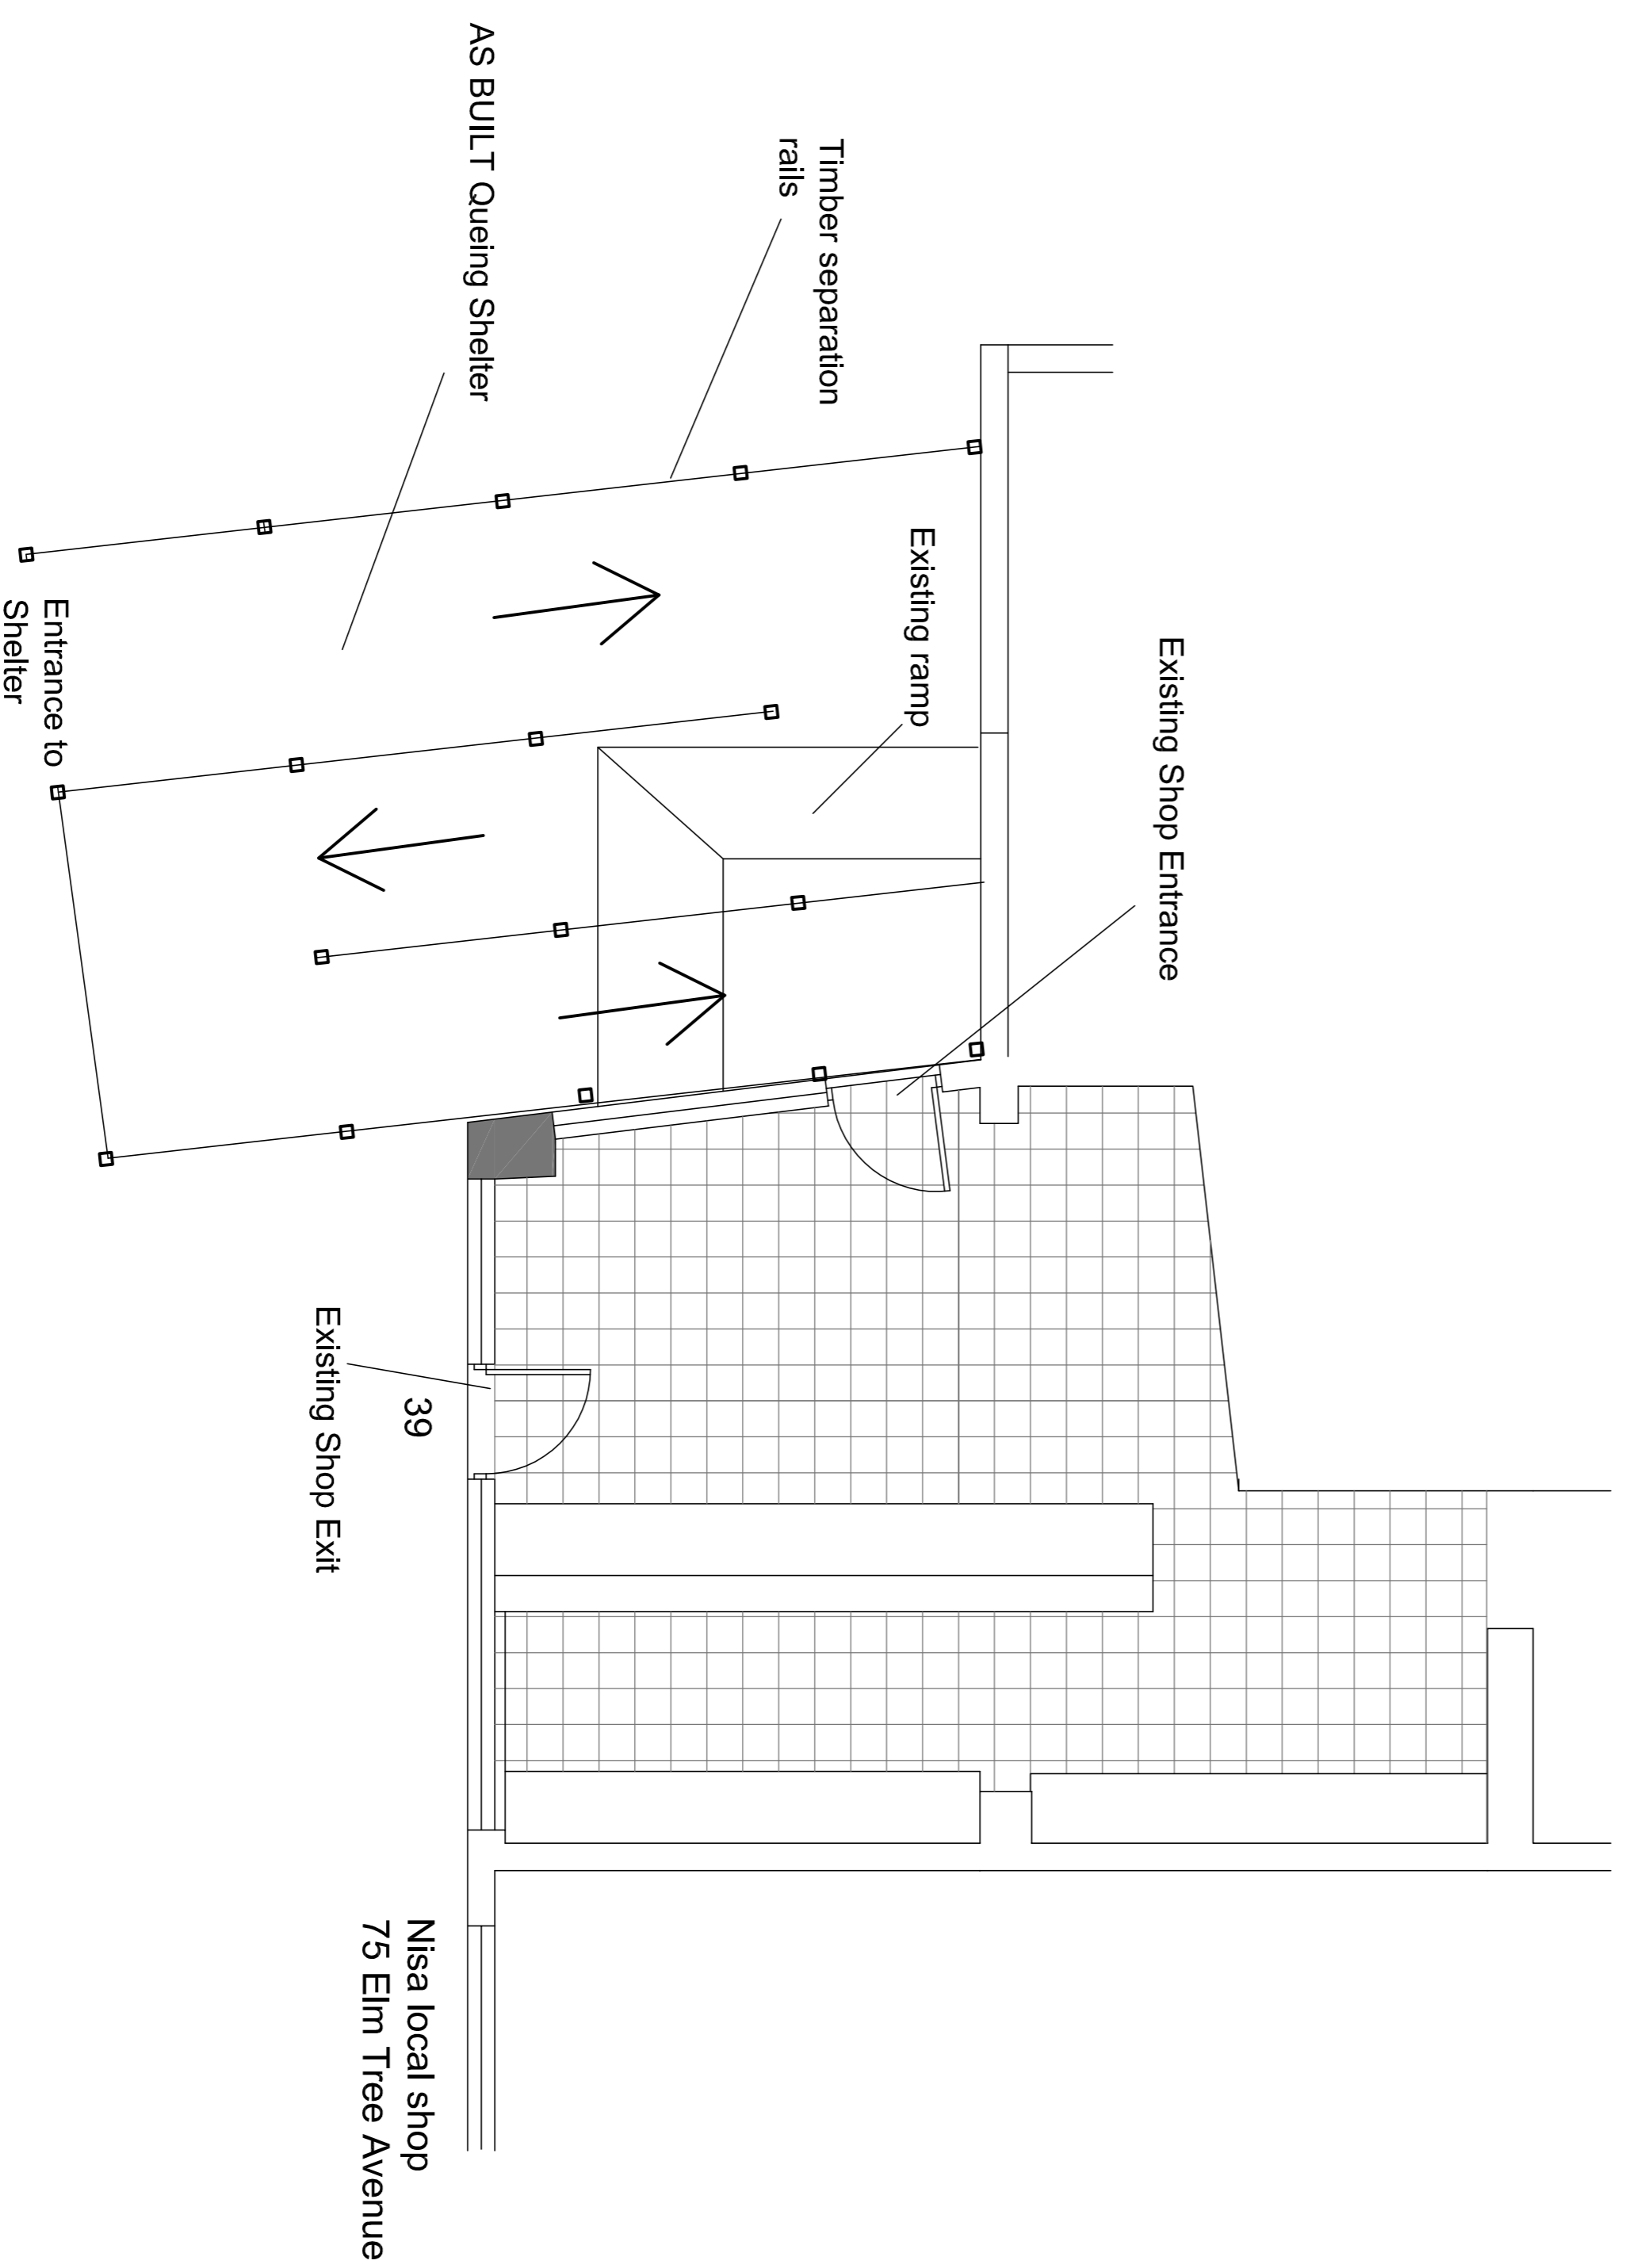


AS BUILT Ground Floor Plan Showing External Queing Shelter
Scale 1:50 @ A1

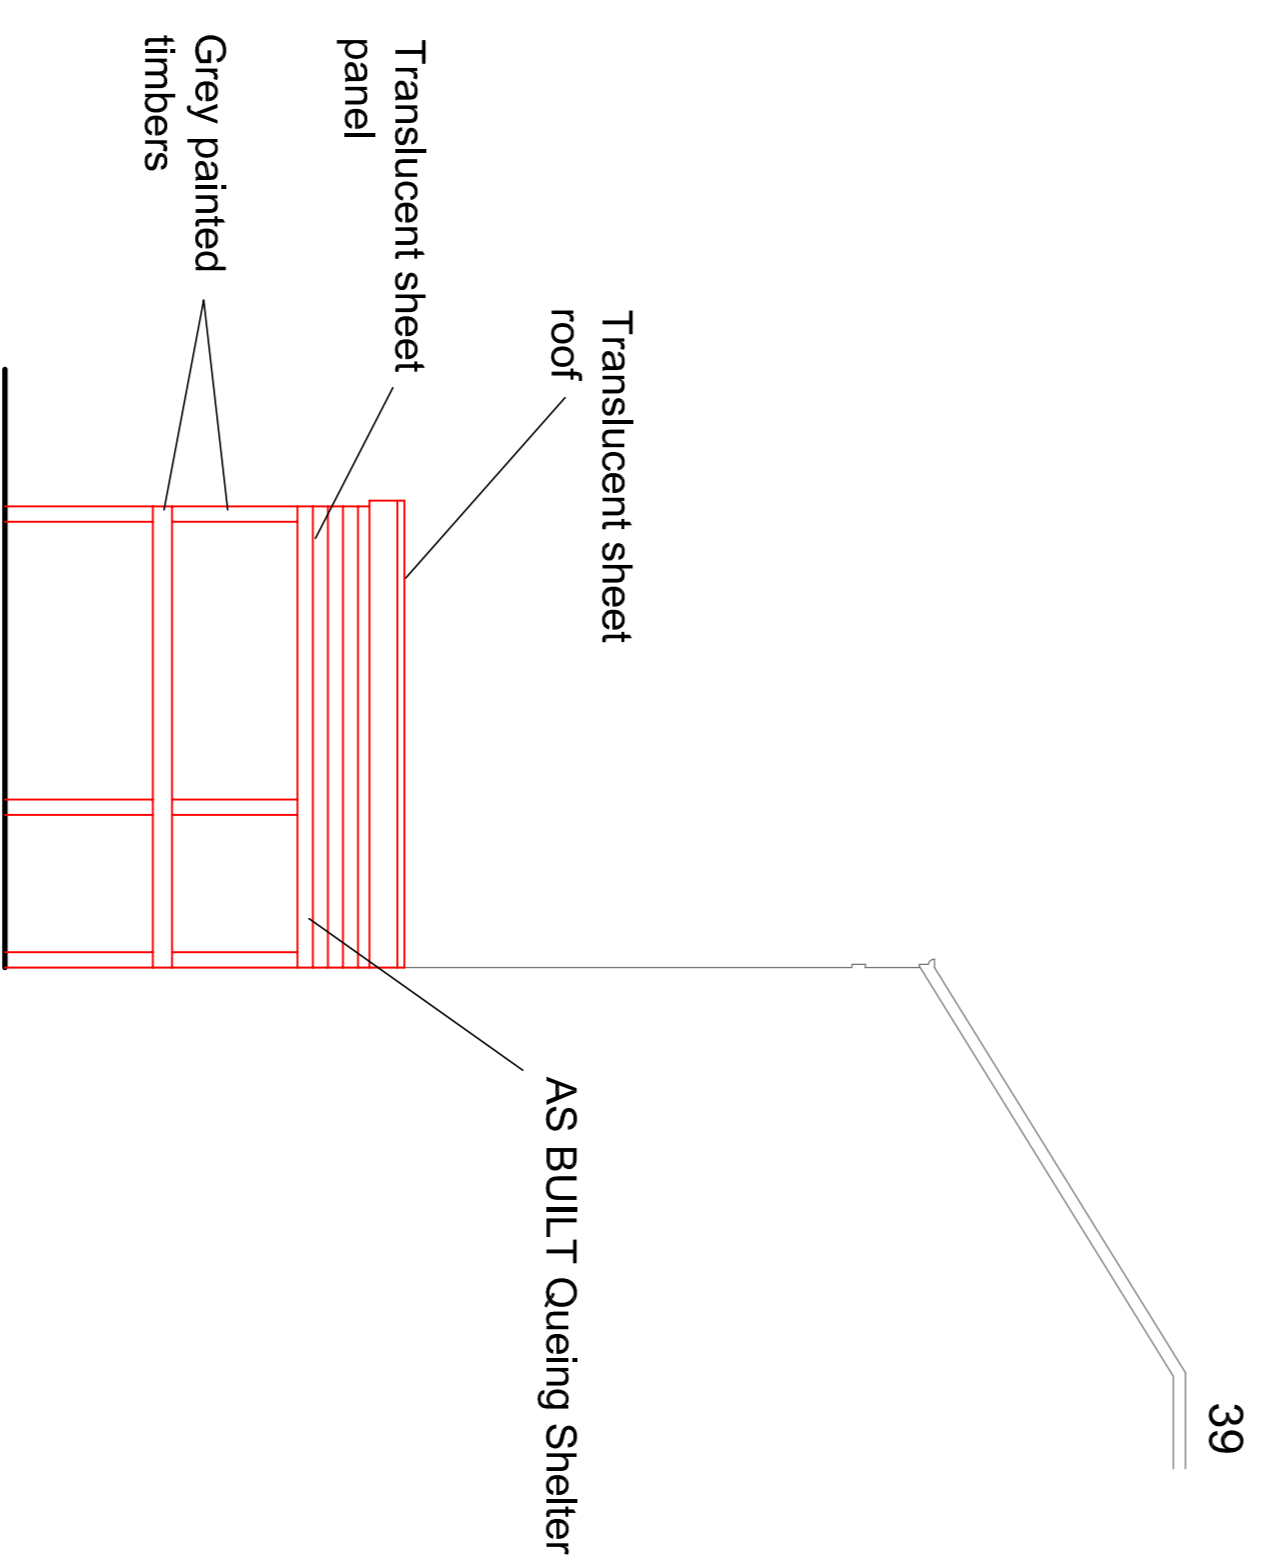


AS BUILT Side Elevation Facing 75 Elm Tree Avenue
Scale 1:50 @ A1




PLANNING SUBMISSION

item	date	by	checked by
 cdrb architects ltd 91666 Coast Kingsmead CV9 1DE			
As Built Customer Queing Shelter (due to Covid separation rules) at 39 Beech Tree Avenue Coventry trading as Beech Tree Fish Bar			
AS BUILT Plans and Elevations			
scale	drawn by	date	checked by
1:50 @ A1	CR	October 2020	CDRB
job no.	drawing no.	revision	
T2020	AL/P/11	-	-

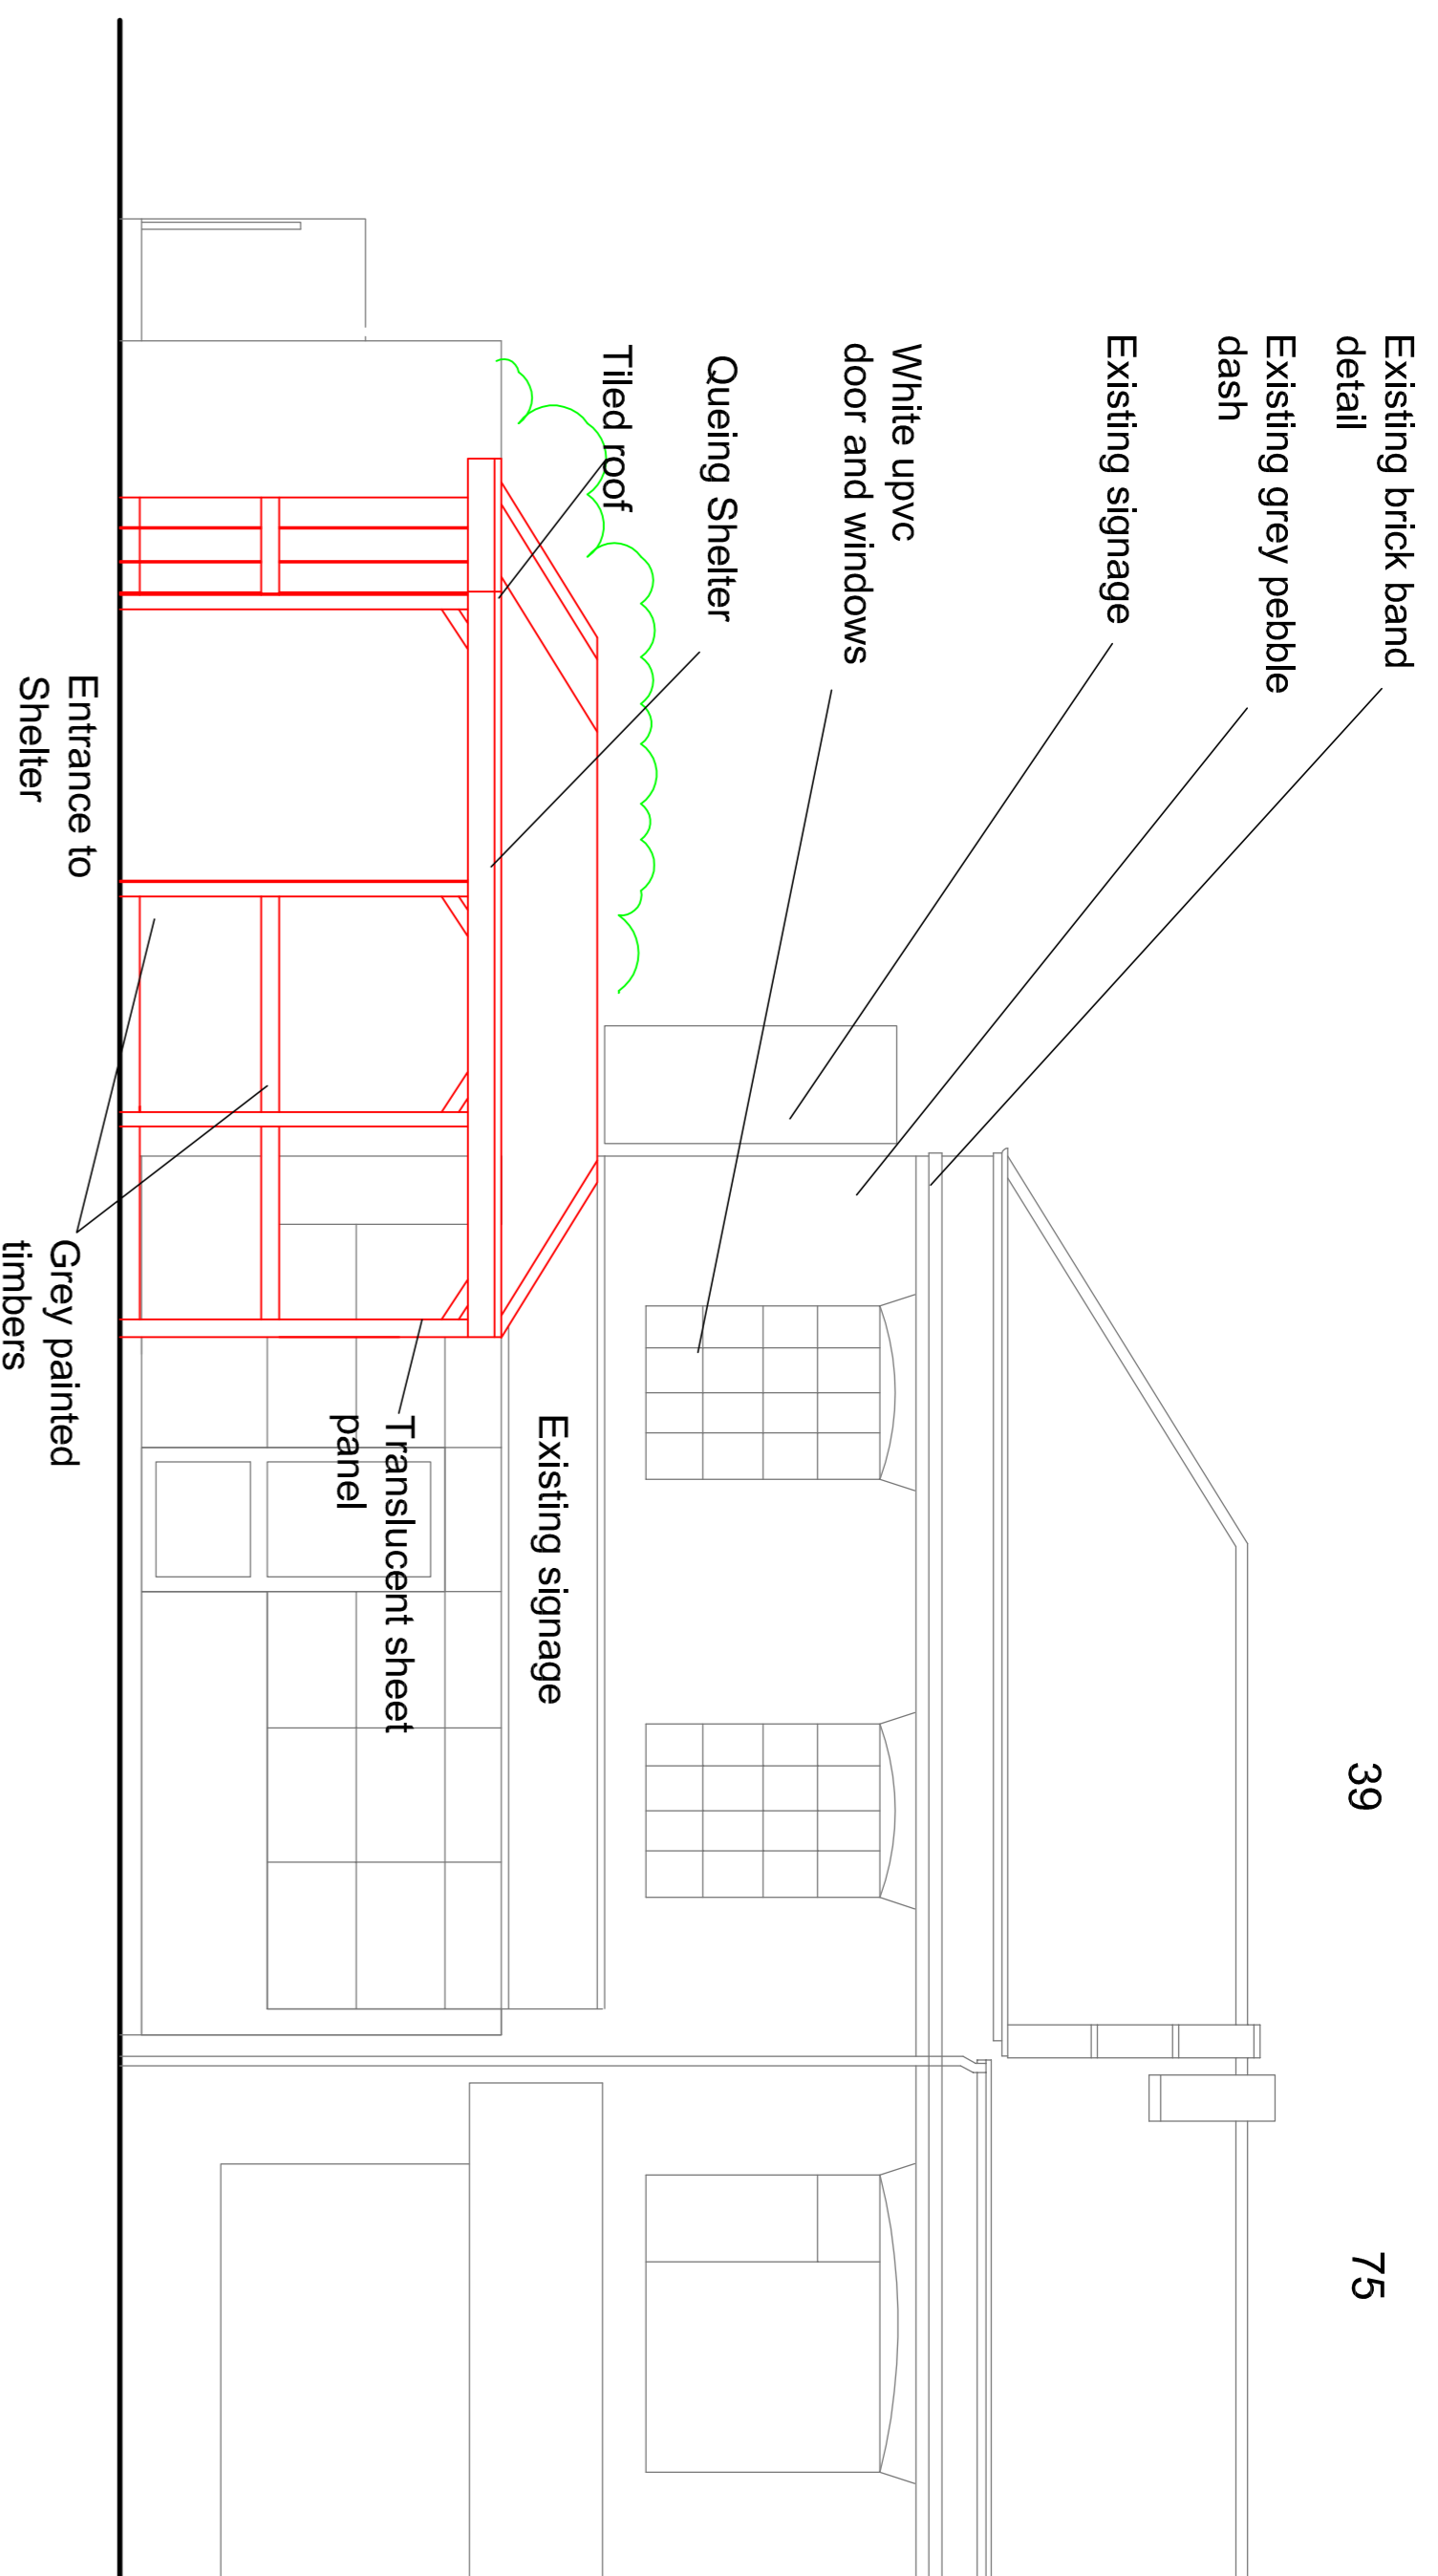


Side Elevation Facing Elm Tree Avenue
Scale 1:50 @ A1

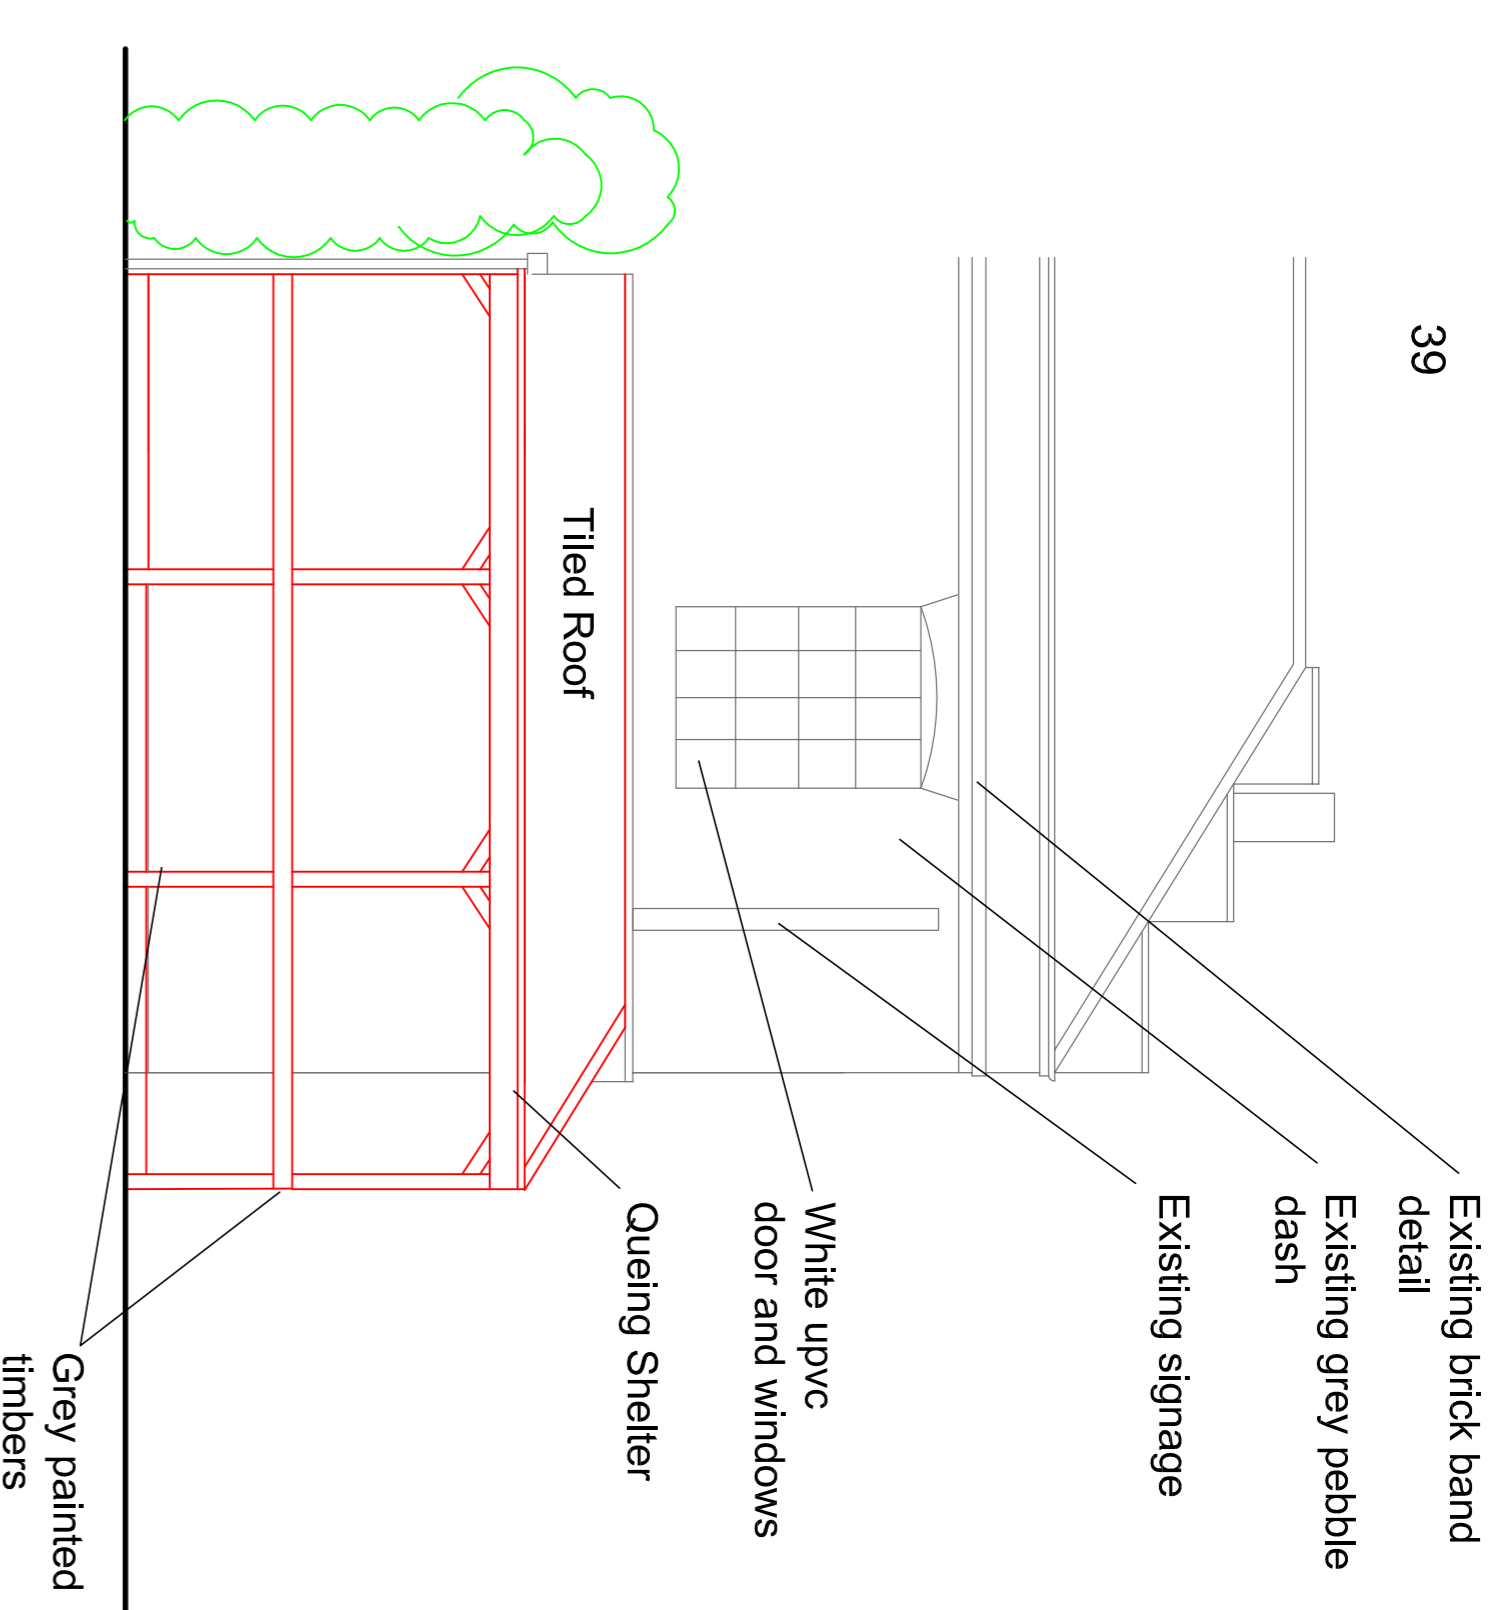


Side Elevation Facing Beech Tree Avenue
Scale 1:50 @ A1


GENERAL NOTES
DRAWING CAN BE SCALED FOR PLANNING PURPOSES ONLY BUT IF IN ANY DOUBT ABOUT A DIMENSION OR ANY OF THE DRAWING INFORMATION PLEASE ASK CDRB ARCHITECTS LTD.

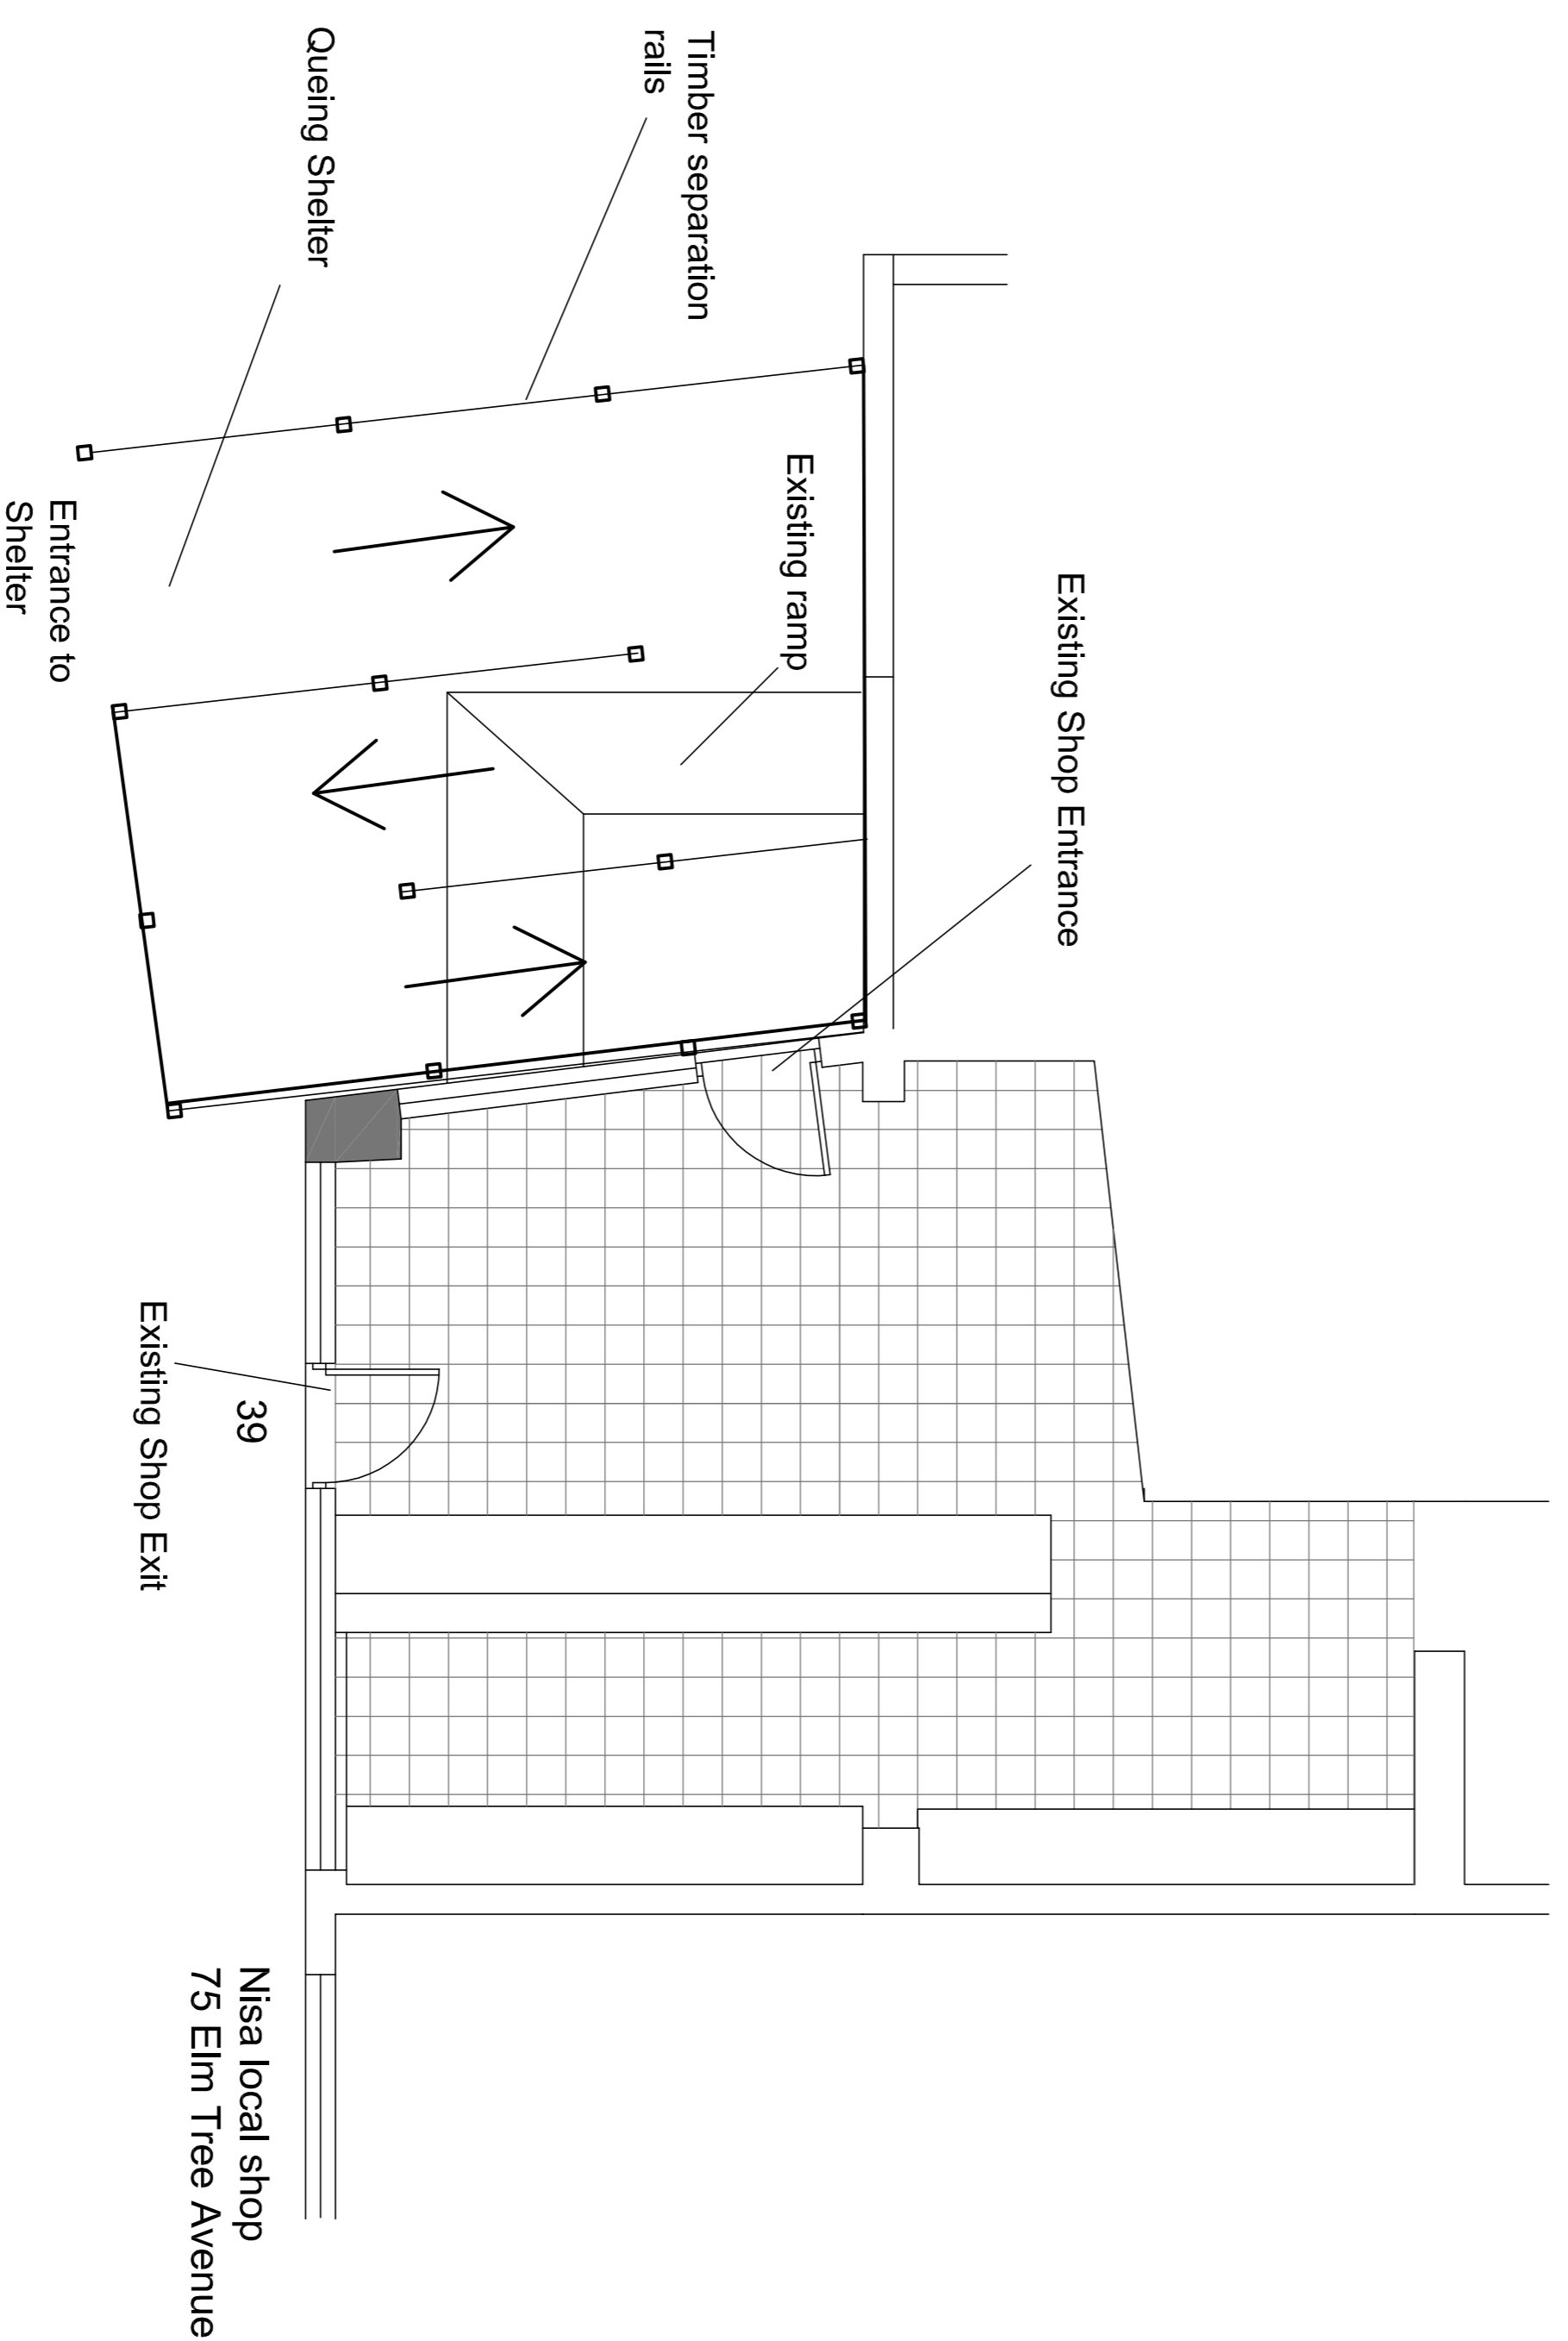

Ground Floor Plan Showing External Queuing Shelter
Scale 1:50 @ A1

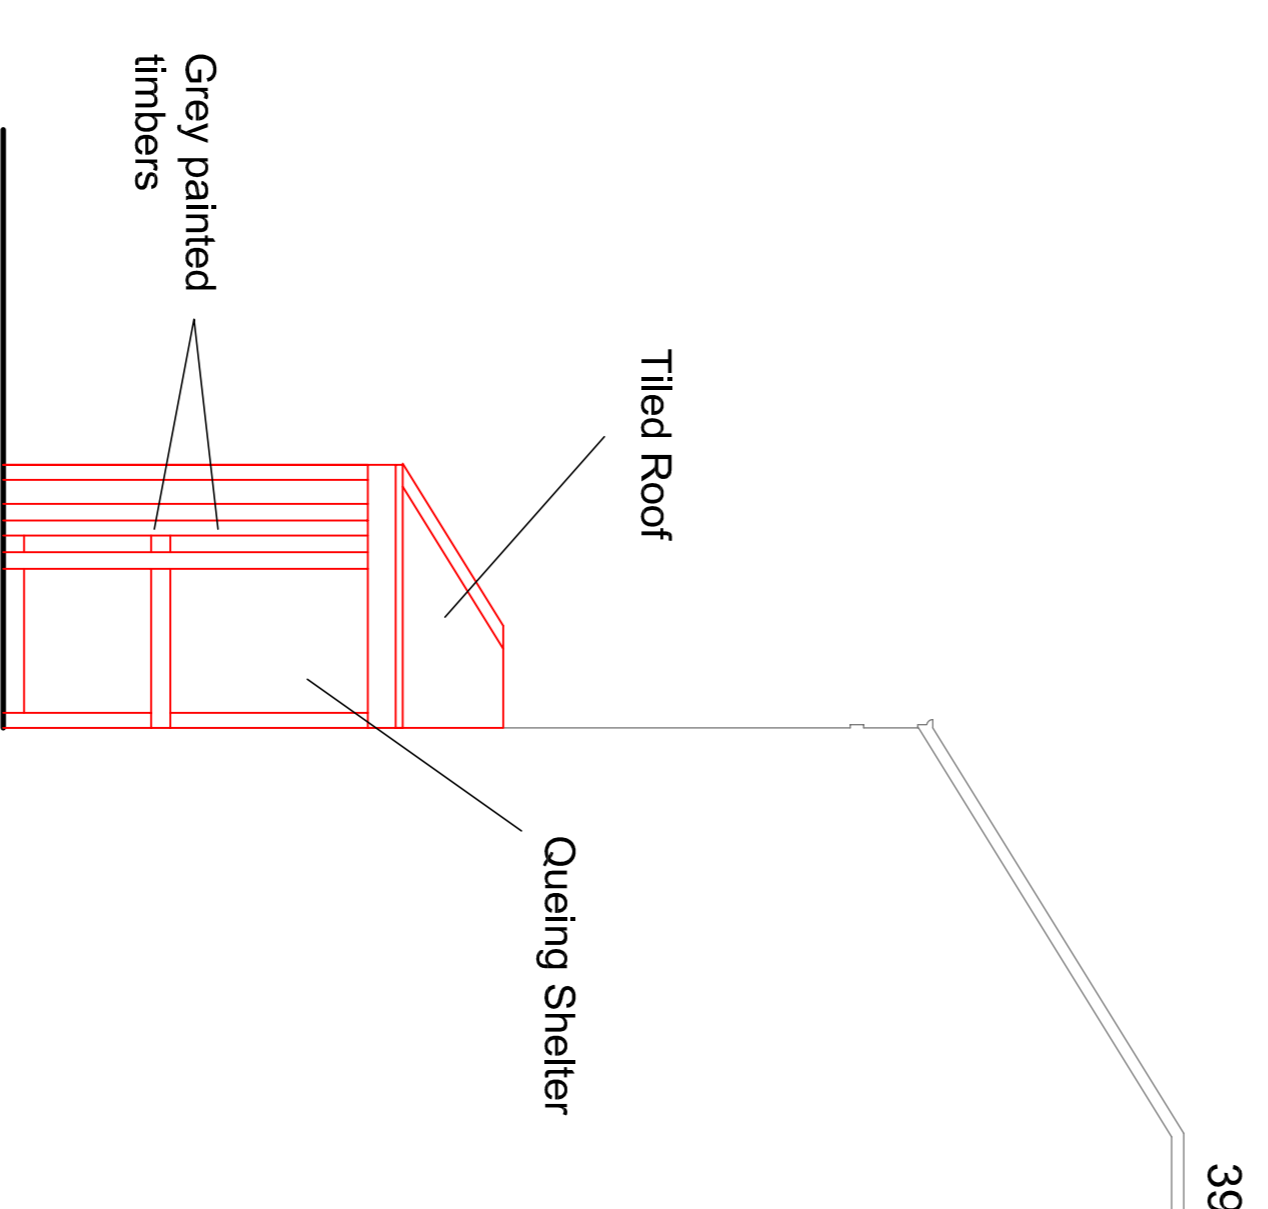

AS BUILT Side Elevation Facing 75 Elm Tree Avenue
Scale 1:50 @ A1

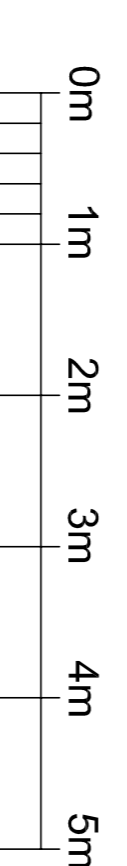

PLANNING SUBMISSION

room	date	drawn by	date	checked by
		CR	February 2021	CDRB
<p>CDRB Coventry Design & Research Bureau Coventry City Council Coventry, CV1 1JG</p>				
<p>Job title: Customer Queuing Shelter (due to Covid separation rules) at 39 Beech Tree Avenue Coventry/trading as Beech Tree Fish Bar</p>				
<p>Drawing title: Plans and Elevations</p>				
scale	drawn by	date	checked by	
1:50 @ A1	CR	February 2021	CDRB	
job no.	drawing no.	revision		
72115	AL/P/01			